

WATER SERVICE RECORD

Name DeVries Const. Company

Service No. 344

Address 12 Ewell Avenue

# 4605

Location

~~Repair/Removal~~ - New Service

*Com. 12-28-53*

Date	Material	Amount	Total	Date	Amount
12/16/53	Labor	1 75		10-22-53 Deposited	20 00
	10% Overhead	18	1 93	1-7-54 Paid	4 23
					<u>24 23</u>
	45' - 3/4" Copper tubing @.3629	16 33		12/16/53 Labor	5 75
	1 - 3/4" Cx 1/2" I.W.H. stop & waste	4 00		25- 3/4" Copper tubing @.3629	9 07
	1 - 3/4" Cx 3/4" C. Union 3 pts.	1 72		1 - 3/4" C. corp-cock	4 33
	1 hr. trucking		75	1 - 3/4" Cx 3/4" C. curb-cock	4 67
			<u>24 73</u>	1 box and rod	3 90
	TRENCH DUG BY OWNER:			1-1/2 straight tail piece	50
				1-1/2 offset tail piece	50
				1 hr. trucking	75
					<u>29 47</u>


*Com. 12-29-53*

DATE \_\_\_\_\_

TOWN OF LEXINGTON — BOARD OF PUBLIC WORKS

WATER DIVISION

Sketch of Service Here

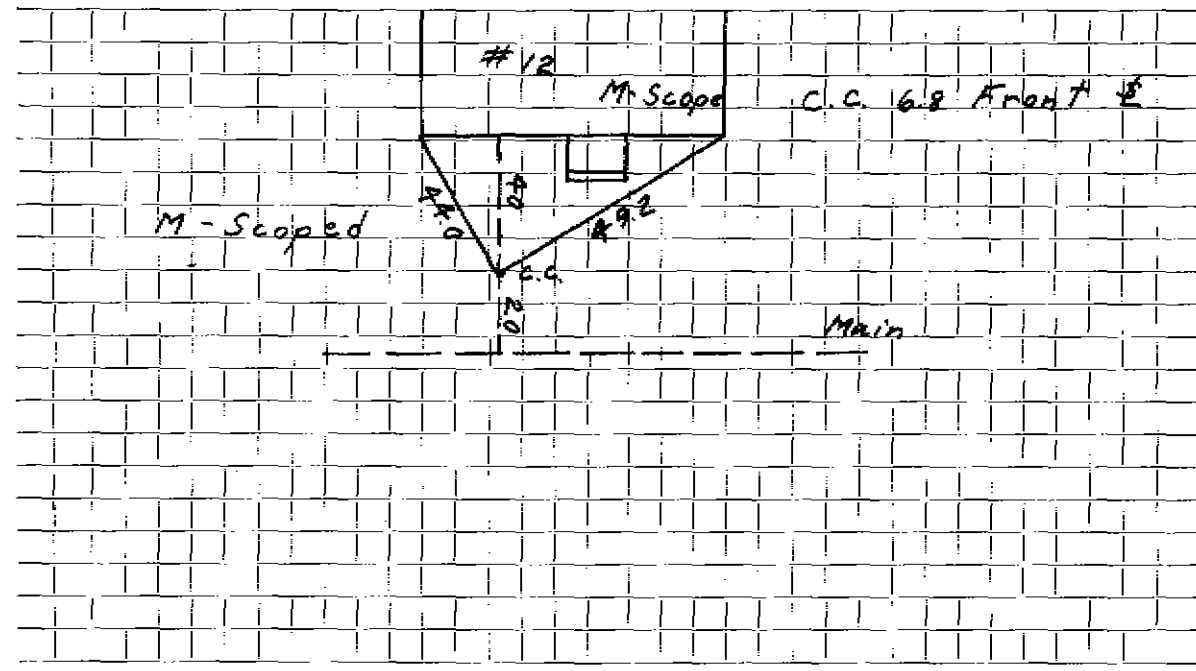

Connection made in ..... Street. Work completed .....

Remarks: .....  
.....  
.....