

WATER SERVICE RECORD

Name DeVries Const Co.

Service No. 334

Address 15 Ewell Ave.

Location Lexington

Repair ~~General~~ - New Service

Jan. 11-23-53

Date	Material	Amount	Total	Date	Amount
11/3/53	Labor	1 75		10-22-53	Deposited 20 00
	10% overhead	18	1 93	12-7-53	Paid 1 20
	10'-3/4" Copper Tubing @.3629		11 52		NON CHARGE 21 20
	1-3/4" C x 3/4" I.W.H. STOP & WASTE		4 00	11/3/53	Labor 5 85
	1 Hr. Trucking		75		10'-3/4" Copper Tubing @.3629 3 63
			21 20		1-3/4" C. Corp-cock 4 33
					1-3/4" C x 3/4" C. Corp-cock 4 67
					1-Bo. & Rod 3 90
					1-3/4 straight tail piece 50
					1-3/4 offset tail piece 50
					1 Hr. Trucking 75
					<u>24 13</u>

TRENCHING BY OWNER


Jan 11-23-53

DATE _____

TOWN OF LEXINGTON — BOARD OF PUBLIC WORKS

WATER DIVISION

Sketch of Service Here

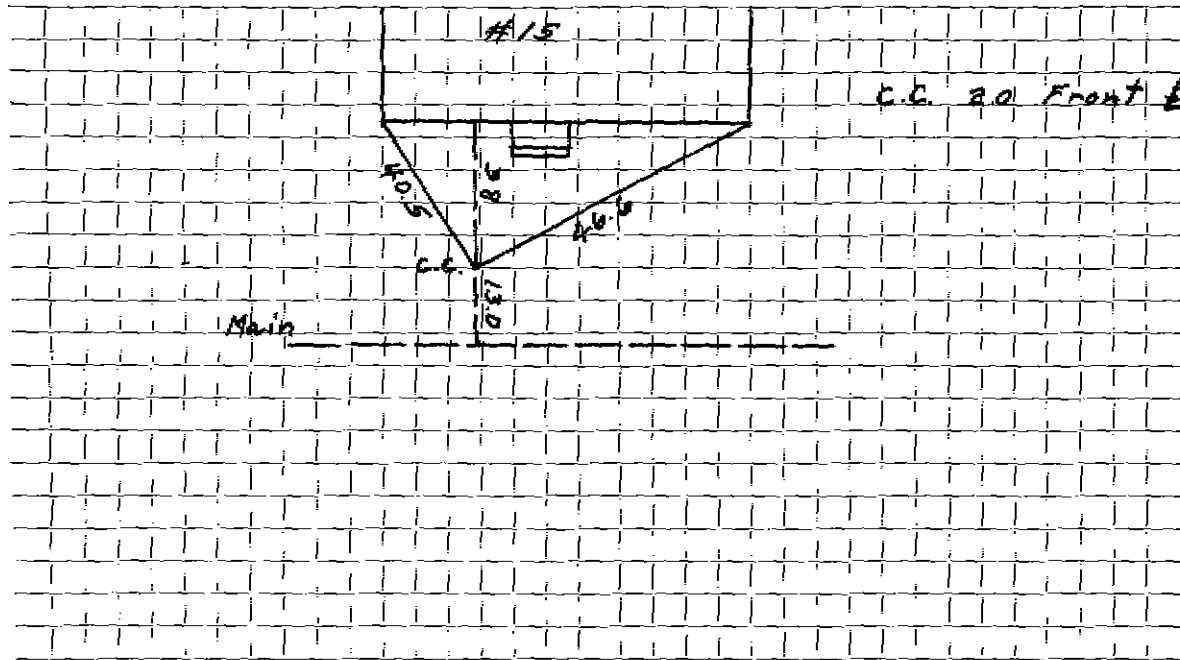

Connection made in Street: Work completed

Remarks:
.....
.....