

WATER SERVICE RECORD

Name George Muller

Service No. 228

Address 24 Ewell Road

2215

Location

Repair: Breakaway - New Service


Com. 9-14-53

Date	Material	Amount	Total	Date		Amount
8/6/53	Labor	1 75		8-6-53	Deposited	20 00
	10% Overhead	18	1 93	9-14-53	Refunded	1 29
	45' - 3/4" Copper tubing @ .3629	16 33			NON CHARGE	2 00
	1 - 3/4" Cx 1/2 I.W.H. stop & waste	4 00	8/6/53	Labor		1 75
	1 hr. trucking	.75	23 01	27' - 3/4" Copper tubing @ .3629		9 80
				1 - 3/4" C. curb-cock		4 33
				1 - 3/4" Cx 3/4" C. curb-cock		4 67
	TRENCH DUG BY OWNER			1 - 3/4" C x 3/4" C. Union 3 pts.		1 72
				1 box and rod		3 90
				1 - 1/2 offset tail piece		50
				1 - 1/2 straight tail piece		50
				1 hr. trucking		75
						27 92

DATE _____

TOWN OF LEXINGTON - BOARD OF PUBLIC WORKS
WATER DIVISION

Sketch of Service Here

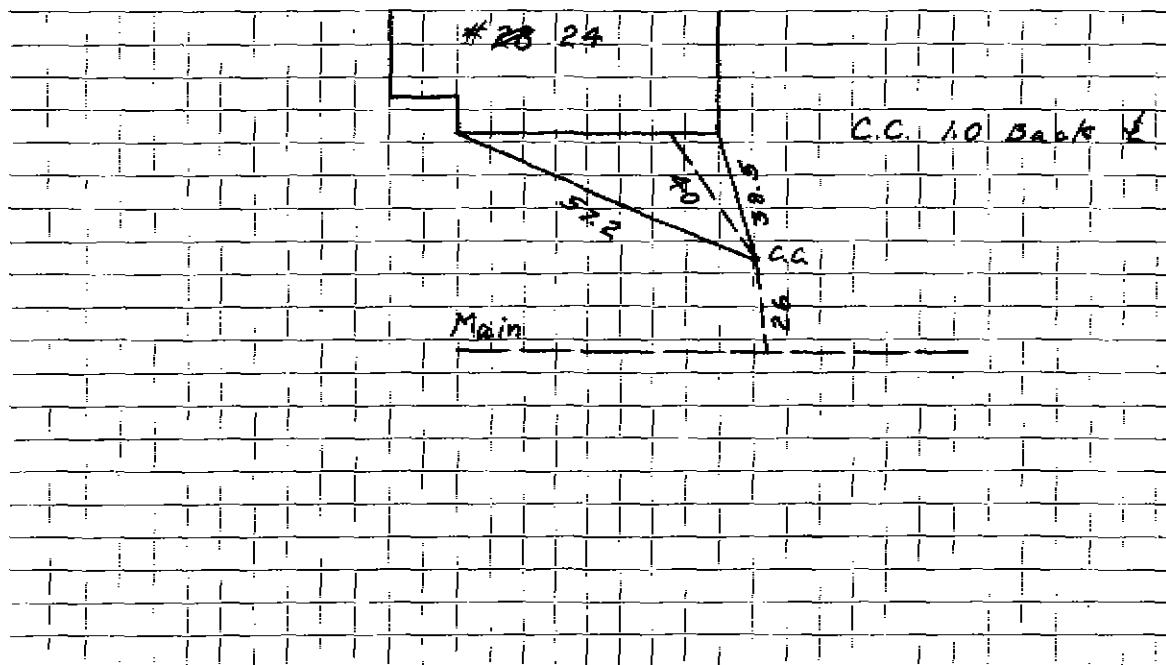

Connection made in Street. Work completed

Remarks:

.....
.....