

WATER SERVICE RECORD

Name DeVries Const Co.

Service No.

336

Address 25 Ewell Ave.

3663

Location Lexington

Repair Removal—New Service

Com. 11-23-53


Date	Material	Amount	Total	Date	Amount
11/3/53	Labor	1 75		10-22-53	Deposited 20 00
	10% overhead	18	1 93	10-22-53	Paid (1 20)
	10'-3 1/4" Copper Tubing @ .3629	1 52			NON CHARGE 21 20
	1-3/4" C x 1/8 I.W.H. STOP & WASTE	4 00	11/3/53 Labor		5 85
	1 Hr. Trucking	75	10'-3 1/4" Copper tubing @ .3629		3 63
		21 20	1-3/4" C. Corp-cock		4 83
			1-3/4" C curb-cock		4 07
			1-Box & Rpd		3 90
			1-1/2 straight tail piece		50
			1-1/2 offset tail piece		50
			1 Hr. Trucking		75
					24 13
	TRENCH DUG BY OWNER				

10-22-53

DATE _____

TOWN OF LEXINGTON — BOARD OF PUBLIC WORKS
WATER DIVISION

Sketch of Service Here

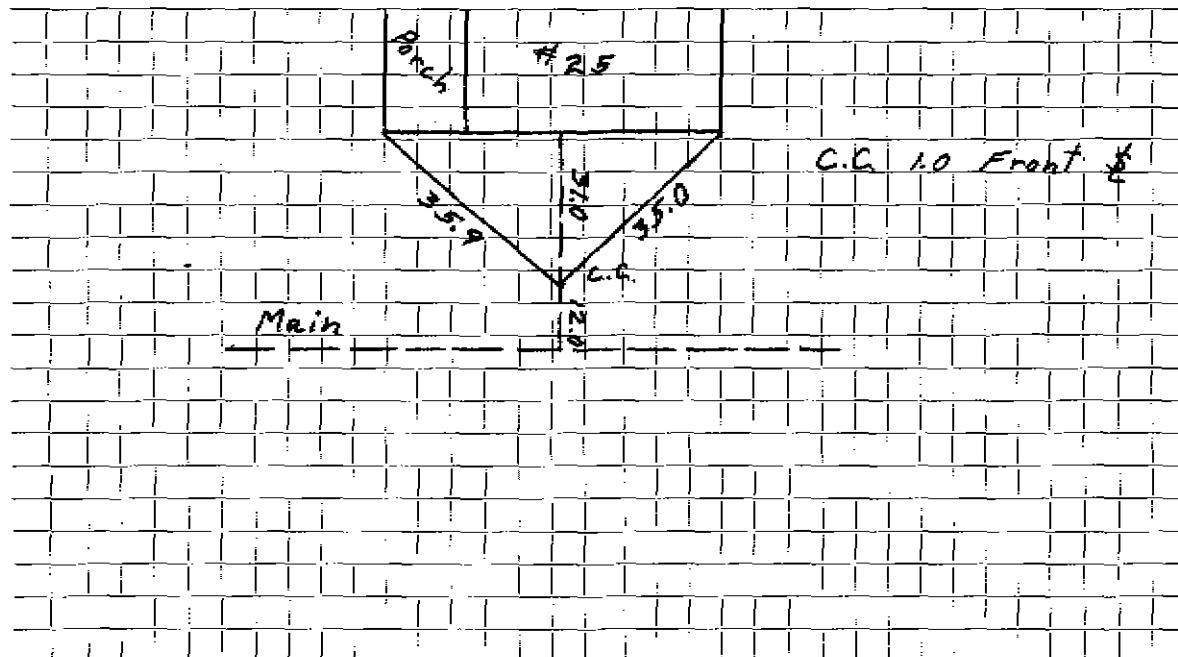

Connection made in Street. Work completed

Remarks:

.....
.....