

4909

WATER SERVICE RECORD

Name DeVries Const. Co.

Service No. 337

Address 27 Trull Ave.

Location

Repair - ~~Renewal~~ - New Service

Con. 12-28-53

Date	Material	Amount	Total	Date	Amount
12/11/53	Labor	1 75		10-22-53	Deposited 20 00
	10% overhead	18	1 93	1-7-54	Paid (3 01
	48' - 3/4" copper tubing @ .3629	17 33			REF. CHARGE 23 01
	1 - 3/4" C x 1/2 I.D. stop & waste	4 00		12/11/53	Labor 7 75
	1 hr. trucking		75	10' - 3/4" copper tubing @ .3629	5 33
			23 01	1 - 3/4" C. comp-cock	4 33
	INVOICE DUE BY OWNER:			1 - 3/4" C x 3/4" C. curb-cock	4 27
				1 box and rod	3 90
				1 - 1/2 straight tail pc.	50
				1 - 1/2 offset tail pc.	50
				1 hr. trucking	75
					23 03


12-28-53

DATE _____

TOWN OF LEXINGTON — BOARD OF PUBLIC WORKS

WATER DIVISION

Sketch of Service Here

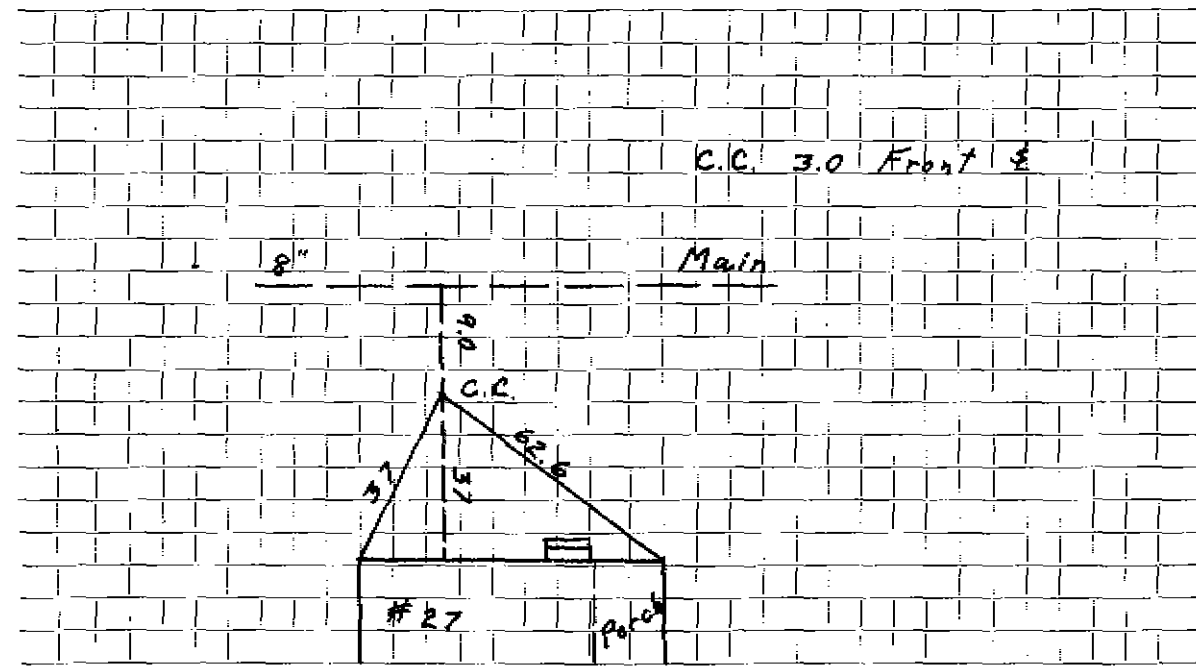

Connection made in Street. Work completed

Remarks:
.....
.....