

WATER SERVICE RECORD

Name DeVries Const. Co.

Service No. 348

Address 28 Ewell Ave.

Location

Repair ~~Renewal~~ New Service

Com. 12-28-53


Date	Material	Amount	Total	Date	Amount
12/15/53	Labor	1 75		11-24-53	Deposited 20 00
	10% Overhead	18	1 93	1-7-54	Paid 4 73
	45' - 3/4" Copper tubing @ .3629	16 33			NON CHARGE 24 23
	1 - 3/4" Cx 1/2" I.W.H. stop & waste	4 00		12/15/53	Labor 4 13
	1 - 3/4" Cx 3/4" C. Union 3 pts.	1 72		25' - 3/4" Copper tubing @ .3629	9 07
	1 hr. trucking		75	1 - 3/4" C. curp-cock	4 33
			24 75	1 - 3/4" C. curb-cock	4 67
				1 box and rod	3 90
	TRENCH DUG BY OWNER			1 - 1/2" straight tail piece	50
				1 - 1/2" offset tail piece	50
				1 hr. trucking	75
					<u>27 85</u>

bill sent 12-29-53

TOWN OF LEXINGTON — BOARD OF PUBLIC WORKS

WATER DIVISION

Sketch of Service Here

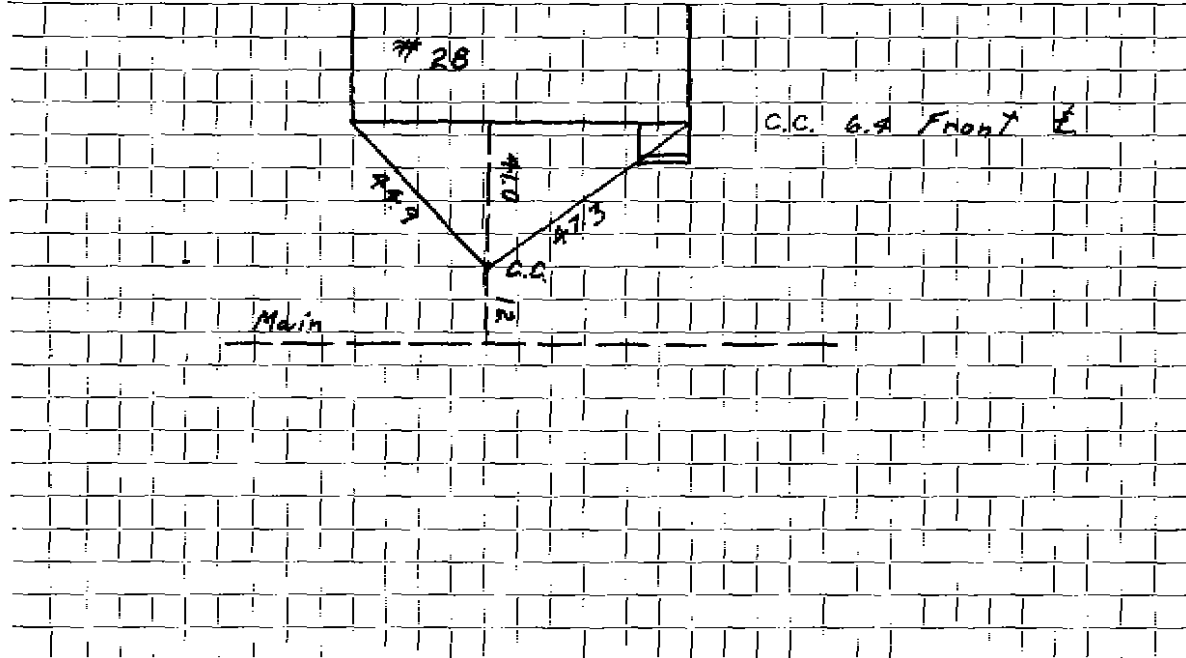

Connection made in Street. Work completed

Remarks:

.....
.....