

WATER SERVICE RECORD

Name DeVries Const. Corp.

Service No. 338

Address 29 Ewell Ave.

Location

~~Repair~~ - New Service

Com. 12-28-53

Date	Material	Amount	Total	Date		Amount
12/15/53	Labor	1 75		10-23-53	Deposited	20 00
	10% Overhead	18	1 93	1-7-54	Paid	23 01
	45' - 3/4" Copper tubing@.3629	16 33			NON CHARGE	23 01
	1 - 3/4" Cx 1/2" I.W.H. stop&waste	4 00		12/15/53	Labor	4 13
	1 hr. trucking		75		10' - 3/4" Copper tubing@.3629	3 63
			23 01		1 - 3/4" C. corp-cock	4 33
					1 - 3/4" Cx 3/4" C. curb-cock	4 67
					1 box and rod	3 90
					1-1/2 offset tail piece	50
					1-1/2 straight tail piece	50
					1 hr. trucking	75
						22 41


TRENCH DUG BY OWNER

Balance 12-28-53

DATE _____

TOWN OF LEXINGTON — BOARD OF PUBLIC WORKS
WATER DIVISION

Sketch of Service Here

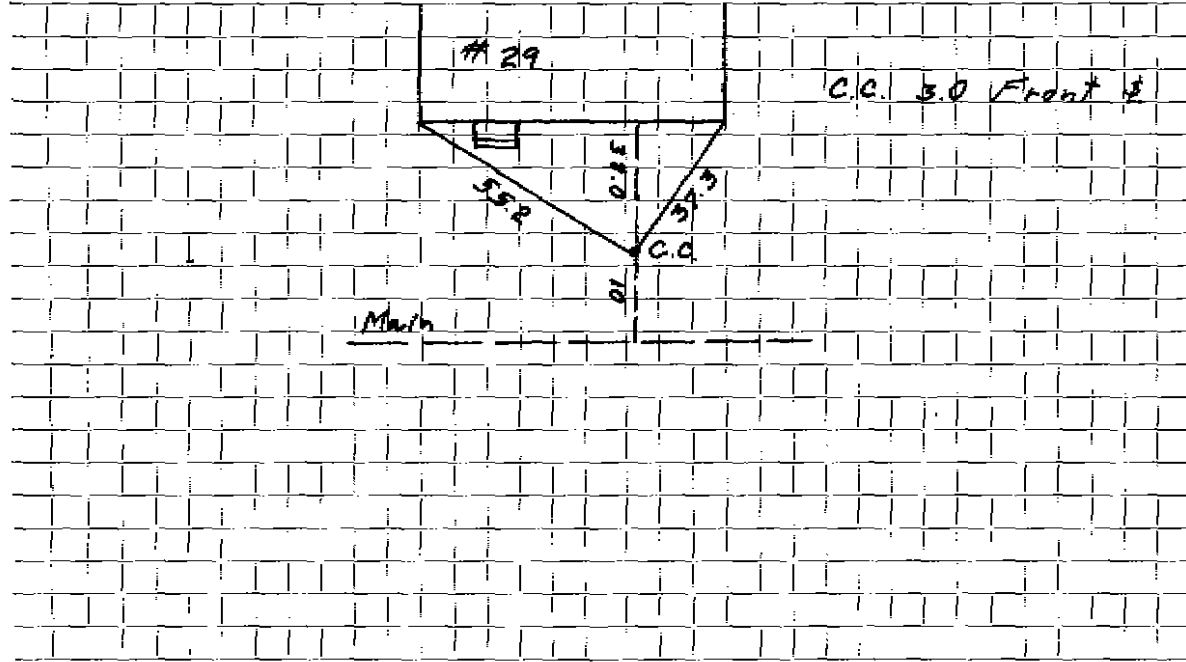

Connection made in Street. Work completed

Remarks:
.....
.....