


DATE 5/2/19

TOWN OF LEXINGTON — BOARD OF PUBLIC WORKS

WATER DIVISION

Sketch of Service Here

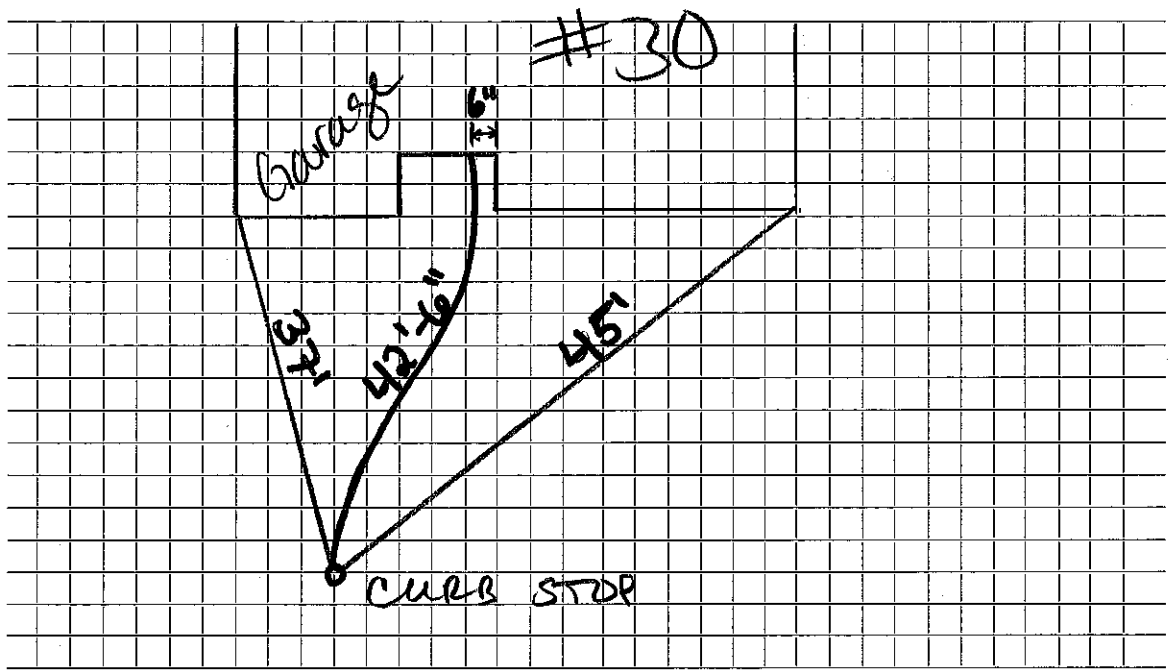

Connection made in EWELL Ave Street. Work completed

Remarks: Ties taken from J McLaughlin