

WATER SERVICE RECORD

Service No. 339

Name DeVries Const. Co.

Address 31 Thell Ave.

Location

Repair—Renewal—New Service

*Com. 12-28-53*

Date	Material	Amount	Total	Date	Amount
12/15/53	Labor	1 75		10-22-53	Deposited 20 00
	10% overhead	18	1 93	1-7-54	Paid (53 01
	48' - 3/4" copper tubing S. 3629	16 35			NEW SERVICE 23 01
	1 - 3/4" C x 1 I. L. H. stop & waste	4 00		12/15/53	Labor 4 15
	1 hr. trucking		75		10' - 3/4" copper tubing S. 3629 3 63
			23 01		1 - 3/4" C. curb-cock 4 25
	CASH ON HAND BY ORDER:				1 - 3/4" C x 3/4" c. curb-cock 4 67
					1 box end rod 3 90
					1 - 3/4" straight tail pc. 50
					1 - 3/4" offset tail pc. 50
					1 hr. trucking 75
					22 41


*Com. 12-29-53*

DATE \_\_\_\_\_

TOWN OF LEXINGTON — BOARD OF PUBLIC WORKS

**WATER DIVISION**

Sketch of Service Here

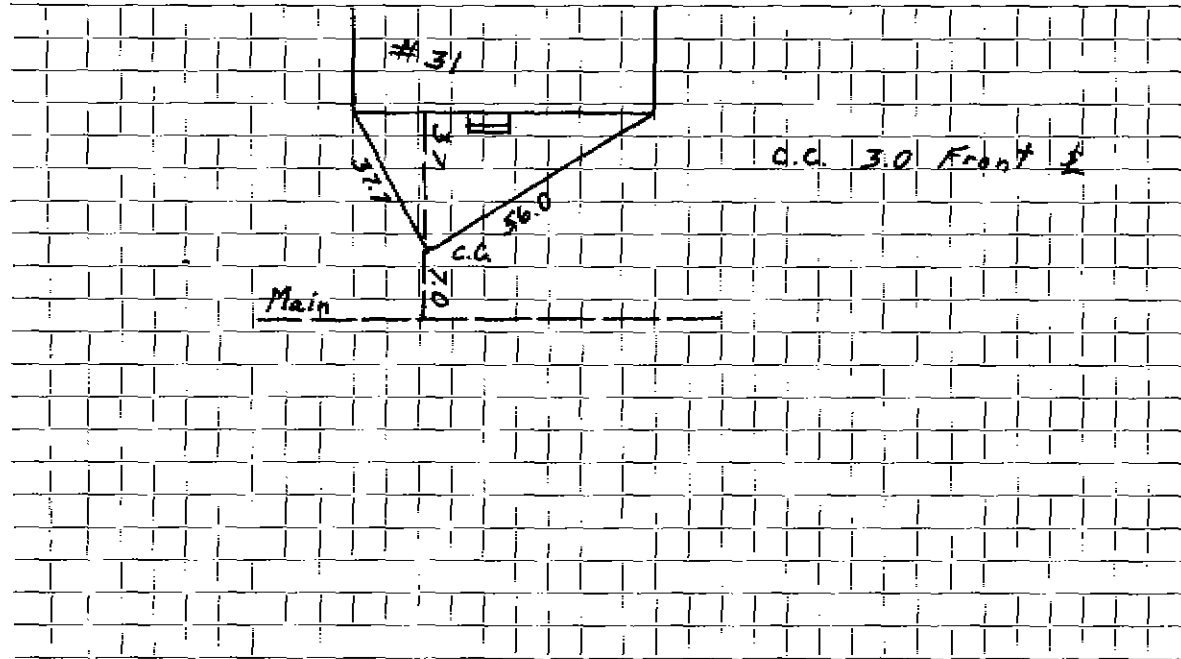

Connection made in ..... Street. Work completed .....

Remarks: .....  
.....  
.....