

WATER SERVICE RECORD

3227

Name DeVries Const. Company

Service No. 340

Address 33 Ewell Ave.

Location

Repair ~~Revised~~ - New Service

Com. 12-28-53


Date	Material	Amount	Total	Date	Amount
12/15/53	Labor	1 75		10-22-53	Deposited 20 00
	10% Overhead	18	1 93	1-7-54	Paid (19 01)
	45' - 3/4" Copper tubing @ .3629	16 33			NON CHARGE 23 01
	1 - 3/4" Cx 1/2" I.W.H. stop & waste	4 00		12/15/53	Labor 4 13
	1 hr. trucking	75		10' - 3/4" Copper tubing @ .3629	3 63
			23 01	1 - 3/4" C. corp-cock	4 33
				1 - 3/4" C x 3/4" C. Curb-cock	4 67
				1 box and rod	3 90
				1 - 1/2" straight tail piece	50
				1 - 1/2" offset tail piece	50
				1 hr. trucking	75
					22 41
	FRENCH DUG BY OWNER;				
				8-9-68	Non Charge
					1 3/4" Curb Cock
					1 Box & Rod

DATE _____

TOWN OF LEXINGTON — BOARD OF PUBLIC WORKS

WATER DIVISION

Sketch of Service Here

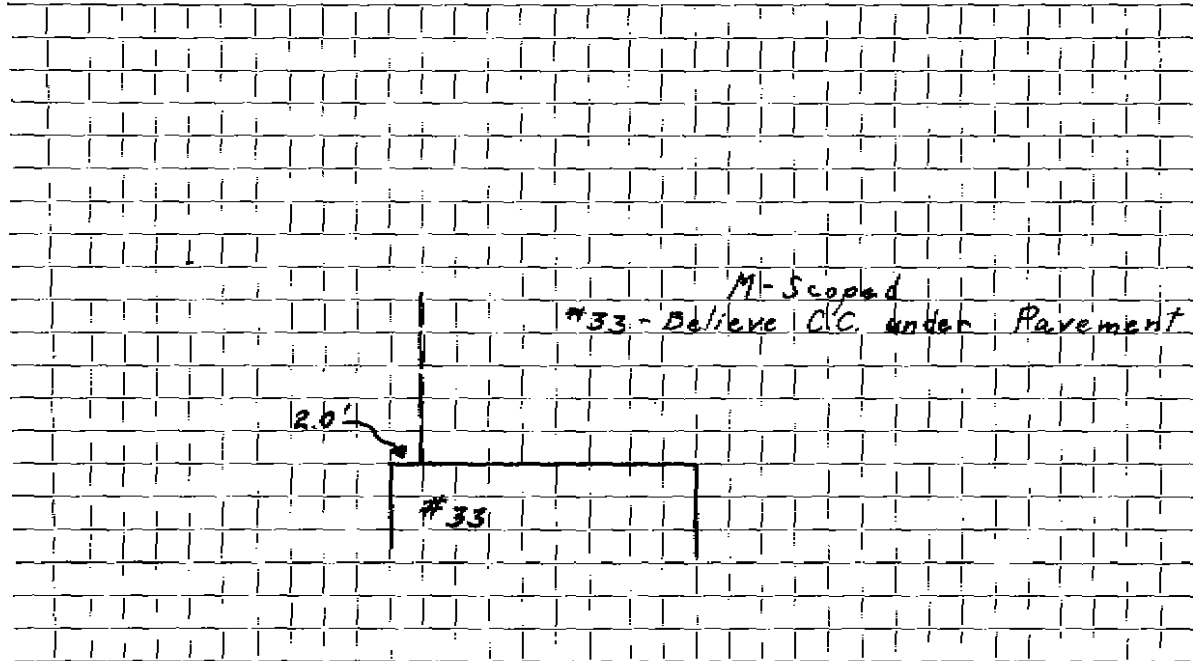

Connection made in Street. Work completed

Remarks:

.....
.....