

WATER SERVICE RECORD

# 5459

Name DeVries Const. Co.

Service No. 341 # 4540

Address 4 Ewell Ave.

Location Lexington

~~Repair~~ ~~XXXXXX~~ - New Service

*Com. 11-30-53*


Date	Material	Amount	Total	Date	Amount
11/19/53	Labor	1 75		10-22-53	Deposited 20 00
	10% overhead	18	1 93	12-14-53	Paid 1 83
	37'-3/4" Copper tubing @.3629		13 43		NON CHARGE 21 83
	1-3/4" C x 1/2 I.W.H STOP & WASTE		4 00	11/19/53	Labor 2 58
	1-3/4" C x 3/4" C. Union(3parts)		1 72		30'-3/4" Copper tubing @.3629 10 89
	1 Hr. Trucking		75		1-3/4" C. Corp-cock 4 33
			21 83		1-3/4" C. x 3/4" C. Curb-cock 4 67
	TRENCH DUG BY OWNER:				1-Box & Rod 3 90
					1-1/2 straight tail piece 50
					1-1/2 offset tail piece 50
					1 Hr. Trucking 75
					28 12

DATE \_\_\_\_\_

TOWN OF LEXINGTON — BOARD OF PUBLIC WORKS

**WATER DIVISION**

Sketch of Service Here

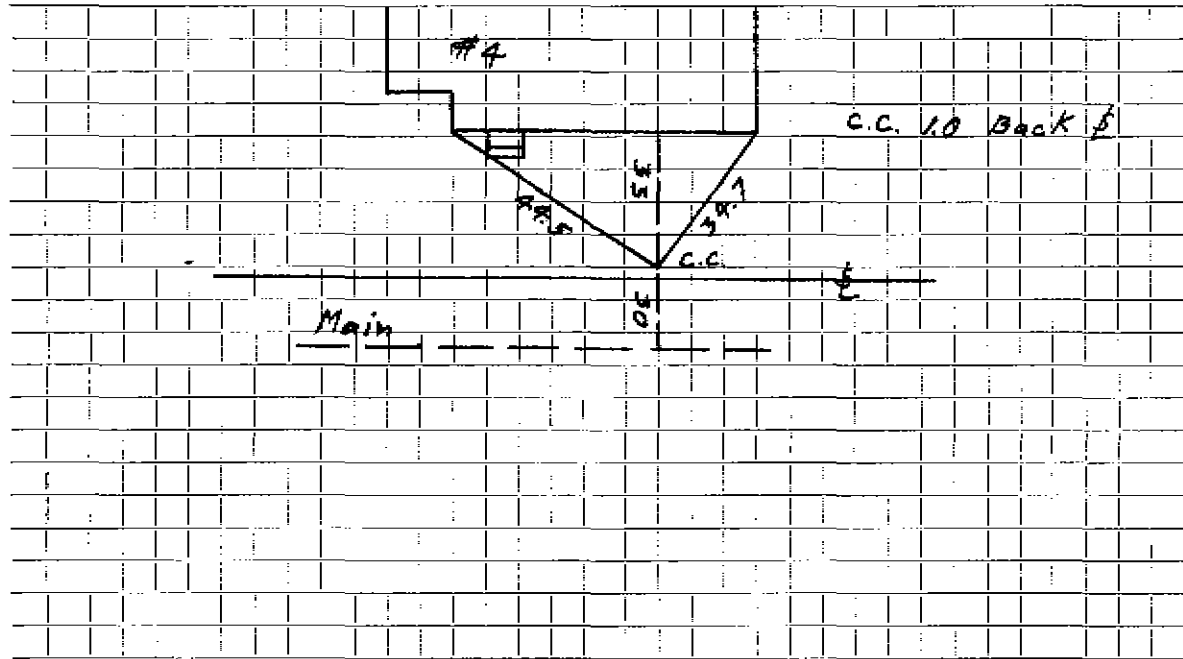

Connection made in ..... Street. Work completed .....

Remarks: .....

.....

.....