

WATER SERVICE RECORD

Name Devries Const. Co.

Service No. 342

Address 6721 Ave.

Location

Repair Renewal New Service


Com. 11-30-53

Date	Material	Amount	Total	Date		Amount
11/19/53	Labor	75		11-22-53	Deposited	20 .00
	10% O.H.	18	193	12-14-53	Paid	1 .83
	37' 3/4" Copper tubing @3629		13.43		NON CHARGE	.21 .83
	1 3/4" Cx1½ I.W.H. Stop & Waste	4.00	11/19/53	Labor		2 .58
	1 3/4" Cx3/4" C. Union(3Parts)	1.72		10' 3/4" Copper tubing @3629	10	.89
	1 Hr. Trucking	75		1 3/4" C. Curb cock		4 .33
		21.63		1 3/4" cx3/4" c Curb cock		1 .67
				1 Box & Rod		3 .90
				1 1/2 Straight tail piece		.50
				3 1/2 Offset tailpiece		.50
				1 Hr. Trucking		.75
						28.12

DATE _____

TOWN OF LEXINGTON — BOARD OF PUBLIC WORKS
WATER DIVISION

Sketch of Service Here

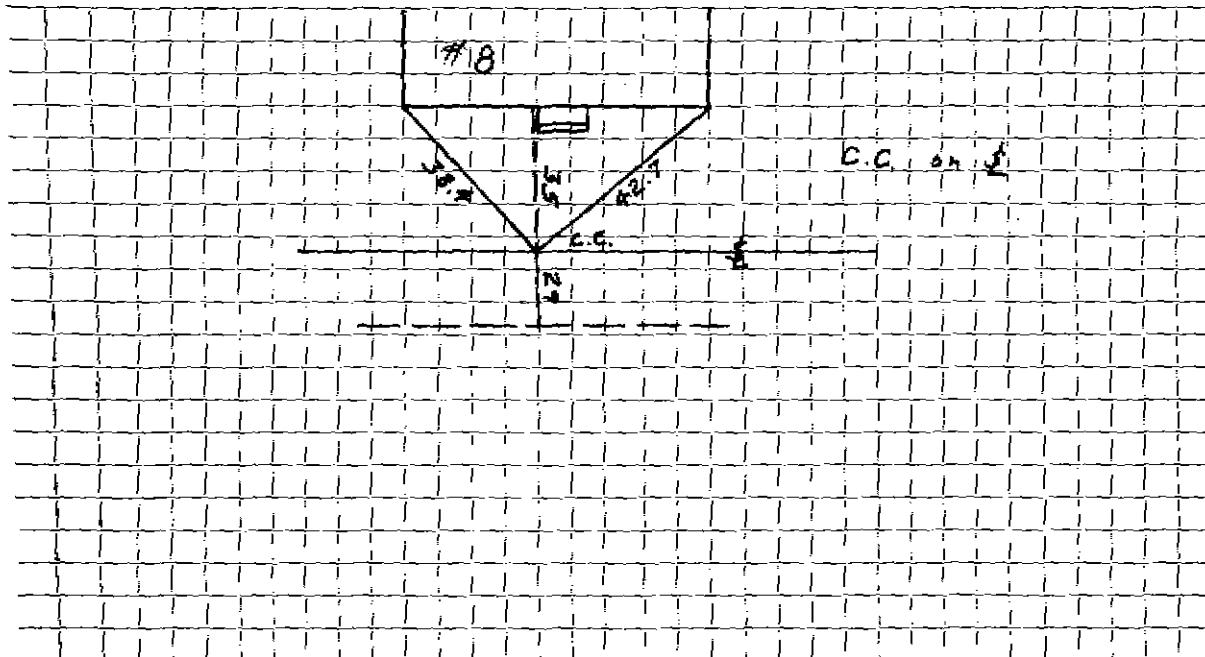

Connection made in Street. Work completed

Remarks:
.....
.....