


TOWN OF LEXINGTON - BOARD OF PUBLIC WORKS
WATER DIVISION

Date: 6/28/21

SKETCH OF SERVICE HERE

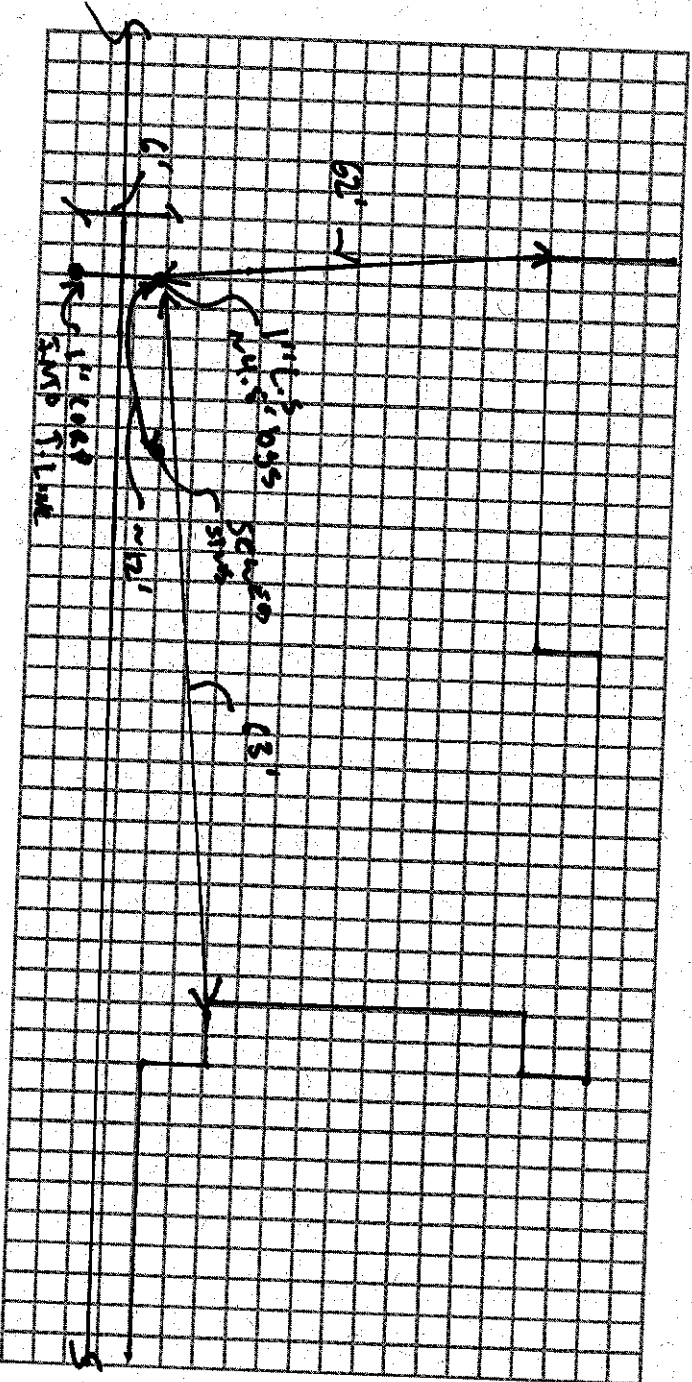

Connection made in: Eliot

Street:

Work completed:

Remarks: X 1\"' CORP S&W TOWN LINE

NTS

Address 8 Elliot

Location

Repair - Renewal - New Service

Date	Material	Amount	Total	Date		A
6/28	1" COPPERATION					
	1" LAMB. BRASS					
	C. STOP					
	Buffalo Box					
	Type K 1" Copper					