

WATER SERVICE RECORD

Name Peter Zimmerman

Service No.

Address 12 FAIR OAKS DR.

Location


Repair Renewal New Service Valeri #0598

Date	Material	Amount	Total	Date		Amount
10-28-91	36 LF 1" COPPER			10-28-91		
					3/4" Copper 3/4" x 1" Curb	
				Nov 02	20' 1" Copper	
					1" COP	
					1" Curb	
					Buff-lo box	

DATE _____

TOWN OF LEXINGTON — BOARD OF PUBLIC WORKS
WATER DIVISION

Sketch of Service Here

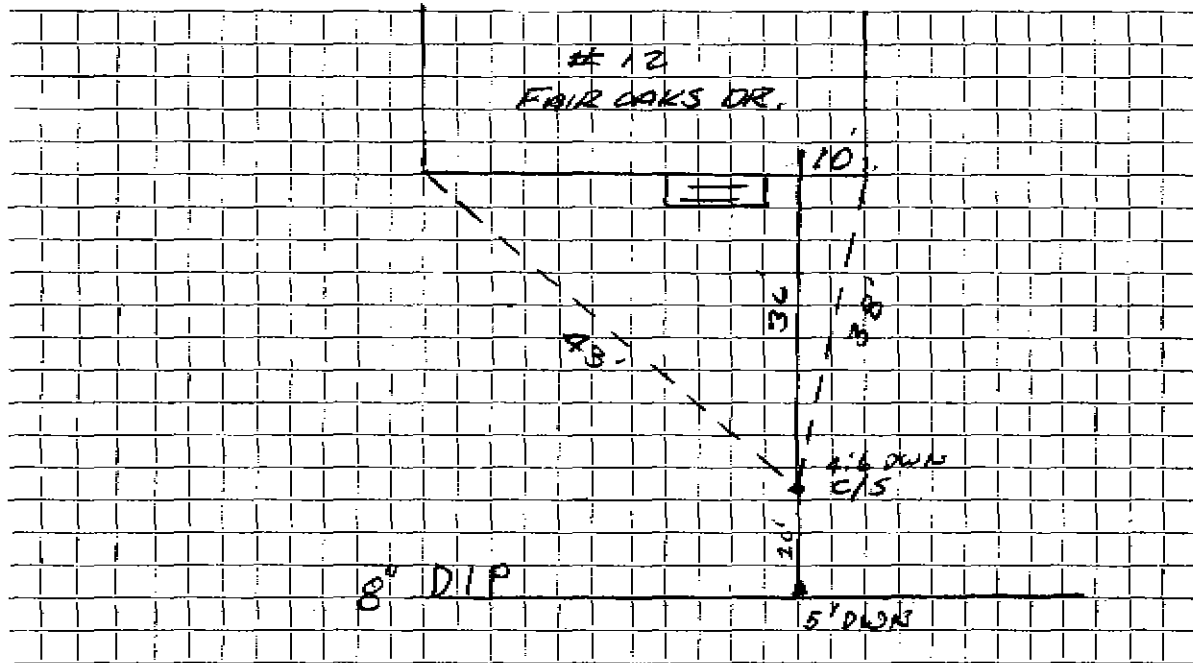

Connection made in FAIR OAKS DR. Street. Work completed 9-24-29

Remarks: RENEWAL - Original Note of J.W. Corp. NEW 2002

Need Reming