

Name Burleigh, Dean F.
 Address Dana St., Cambridge

Service No. ~~34~~ 823

Location ^{#14} Lot #124 Fair Oaks Drive

Kind of Pipe _____ Size _____ Size of Main _____

~~Repair or Renewal~~ - New Service

Location

Date	Material	Amount	Total	Date	Amount
1936					
Sept. 11 67	hrs. labor @ 55¢	36 85		Aug 28 1936	54 00
Com. 9/15/36	" " @ 60¢	9 00	45 85	Sept 18 1936	7 29
8 61 29	10% Ovhd. on labor		4 59		61 29
40'	3/4" Cop. Tub. @ 19¢	7 60			
1	Stop & Waste	1 75			
	Trucking	1 50	10 85		
			61 29		
				110 V. 02	
	Labor			1" Copper	
				1" Corp	
				1" Corv	
				1x3/4 Red	
				bufflo box	

Madley Press, Inc., Lexington

TOWN OF LEXINGTON—BOARD OF PUBLIC WORKS

WATER DIVISION

The undersigned applies for a supply of water at No. Lot # 124 Fair Oaks Dr St. and hereby agrees to comply with the rules and regulations as now, or at any future time, established by the Board of Selectmen.

Am't. of Estimate \$ 54⁰⁰


Owner Dean F. Burleigh Jr.

Am't. Paid \$ _____

Address Dana St. Cambridge

Builder W. Bowman Jackson

Sketch of Service Here

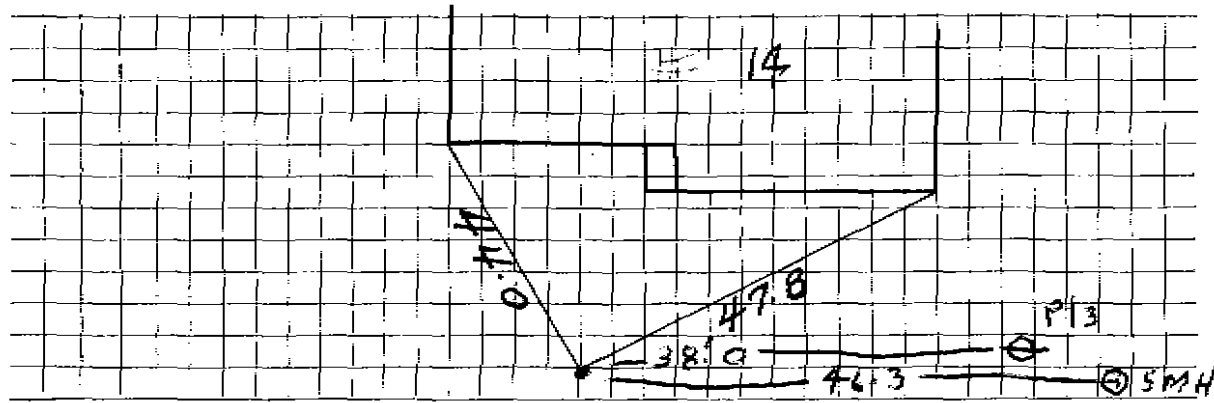

Connection made in _____ Street. Work completed 2002 19

Remarks: