




TOWN OF LEXINGTON — BOARD OF PUBLIC WORKS

WATER DIVISION

Sketch of Service Here

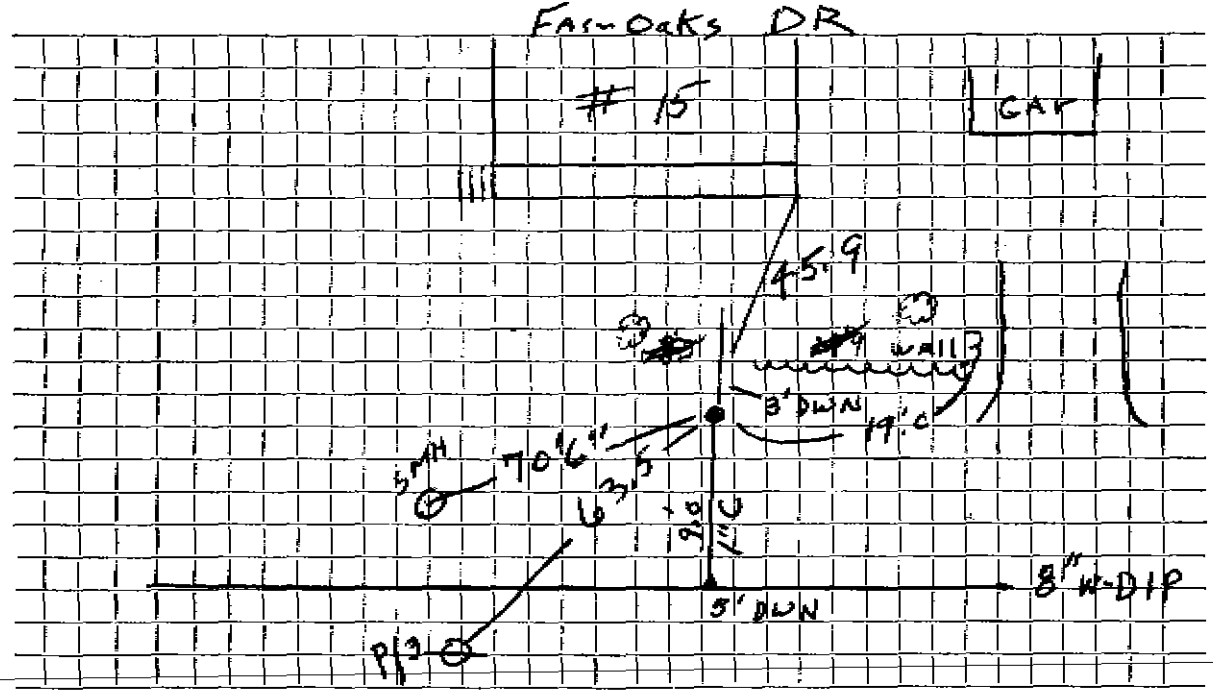

Connection made in ..... Street.

Work completed . NOV . 2002 . Deal Phase 19...

Remarks: .....  
.....  
.....