

Name Mrs. Louie Preston

Service No. ~~82~~ 825

Address 1330 Commonwealth Ave., Allston

Location

Lot ~~13~~ 123 Fair Oaks Drive

Kind of Pipe

Size

Size of Main

~~Repair & Renewal~~ - New Service

Location

Date	Material	Amount	Total	Date	Amount
1937					
6/8/37	2 hrs. @ 60		1 20	<i>June 3, 1937 Deposited</i>	25 00
<i>6/29/37</i>	50' 3/4" Cop. Tubing @ 25¢		12 50		
	1 3/4" Cop. Adapter		5 30		
	1 3/4" S. & W.		3 75		
	2 hrs. trucking @ 75¢		1 50		
	1 3/4" C. Union		25		
			\$ 24 50		
	Say: 50' @ 50¢ per ft.		25.00		
	No Patching.				
	Labor				

Hadley Press, Inc., Lexington

DATE August 1917

TOWN OF LEXINGTON—BOARD OF PUBLIC WORKS

WATER DIVISION

The undersigned applies for a supply of water at No. 123 Fair Oaks Drive ^{Lot} ~~St.~~ and hereby agrees to comply with the rules and regulations as now, or at any future time, established by the Board of Selectmen.

Am't. of Estimate \$ 200

Owner (Mrs) Louie Preston


Am't. Paid \$ _____

Address 1330 Commonwealth Ave

Builder _____

Allston

Sketch of Service Here

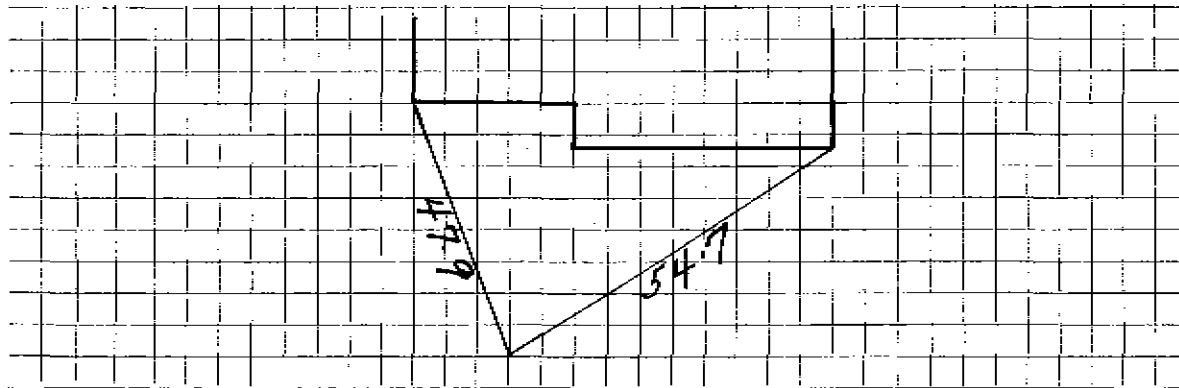

Connection made in _____ Street. Work completed _____ 19

Remarks: