

WATER SERVICE RECORD

2191

Name Dianne Estates Inc.

Service No. 220

Address 17 Fair Oaks Terrace DRIVE

Location

Repair—Renewal—New Service

Comm. 2/16/59


Date		Material	Amount	Total	Date	Amount
10/23/58		Labor	3 70		10/21/58	Deposit \$ 50 00
		10% overhead	37	4 07	2/16/59	Pd. by refund on S.H.C. # 176 \$ 51 75
		95' - 3/4" Copper tubing @ .37	.37	35 15		
		1 - 3/4" Cx 3/2 I.W.H. Stop & Waste		5 84		
		2 - 3/4" C Unions (3 part) @ 2.27	2.27	4 54		NON CHARGE
		1 Bag Rock Wool		1 40		Labor 3 70
		1 hr. Trucking		75		
				51 75		
					12' - 3/4" Copper tubing @ .37	4 44
					1 - 3/4" C Curb Cock	6 03
					1 - 3/4" C Corp Cock	4 64
					1 Box & Rod	5 00
					1 - 1/2" Straight tailpiece	50
					1 - 1/2" Offset tailpiece	50
					NOV 02 4' 1" Copper	24 81
					1" Corp	
					1" Curb STOP	
					1x3/4 Red.	
					buffle box	

DATE _____

TOWN OF LEXINGTON — BOARD OF PUBLIC WORKS

WATER DIVISION

Sketch of Service Here

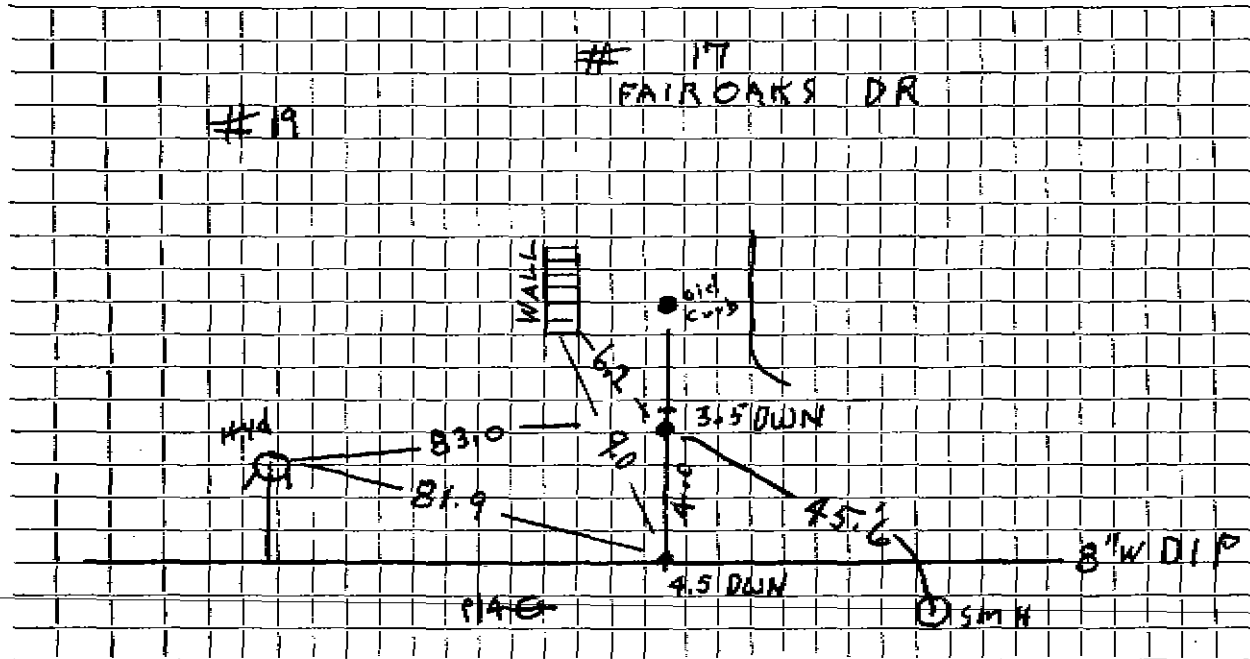

Connection made in Street. Work completed NOV 2002 DEMI.....

Remarks:

.....

.....