

Name Briggs, Walter B. Jr.

Service No. ~~826~~ 826

Address Fair Oaks Drive, Lexington

#1779

Location 22 Fair Oaks Drive

Kind of Pipe

Size

Size of Main

~~Repair-Renewal~~ - New Service

Location

Date	Material	Amount	Total	Date	Amount
1936					
July 10	30 hrs. @ 55¢	16 50		June 30 1936	45 00
	32 " @ 60¢	19 20	35 70	Sept 19 1936	23 42
	10% Ovhd. on labor @ 15¢		3 57		68 42
	40' 3/4" Copper Tub.	6 00			
	1 Stop & Waste	1 75			
	Trucking	1 50			
	5 1/2 hrs. Comp. \$3.00	16 50			
	21 Sts. Dynamite @ 10¢	2 10			
	13 Caps @ 10¢	1 20	29 15		
			68 42		
	Labor				

Hadley Press, Inc., Lexington

30
142
30
15
45.

DATE June 30. 1936.

TOWN OF LEXINGTON - BOARD OF PUBLIC WORKS

WATER DIVISION

The undersigned applies for a supply of water at No. 22 Fair Oaks Drive and hereby agrees to comply with the rules and regulations as now, or at any future time, established by the Board of Selectmen.

Am't. of Estimate \$ 45⁰⁰

Owner Walter B. Briggs, Jr.


Am't. Paid \$ 45⁰⁰

Address Fair Oaks Drive

Builder W.B. Judkins

By W.B. Judkins

Sketch of Service Here

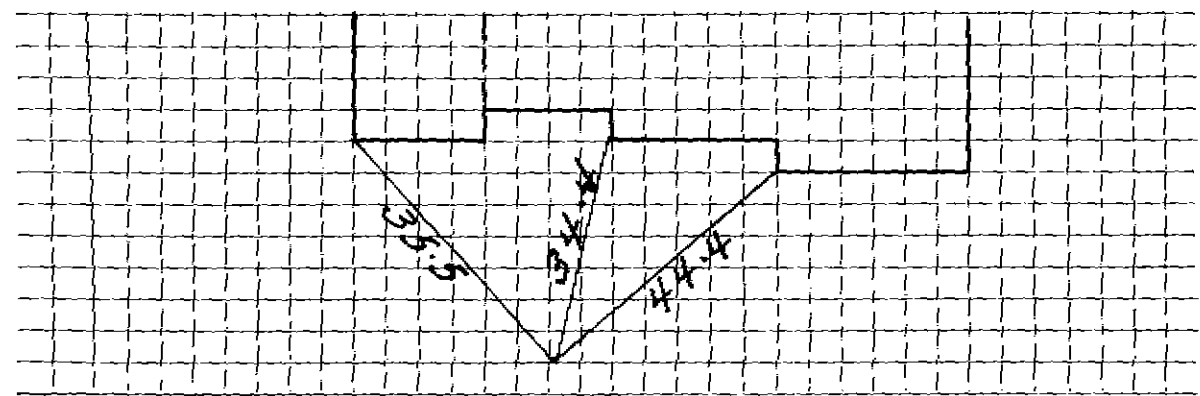

Connection made in _____ Street. Work completed _____ 19

Remarks: