




DATE 10-19-'90

TOWN OF LEXINGTON — BOARD OF PUBLIC WORKS

WATER DIVISION

Sketch of Service Here

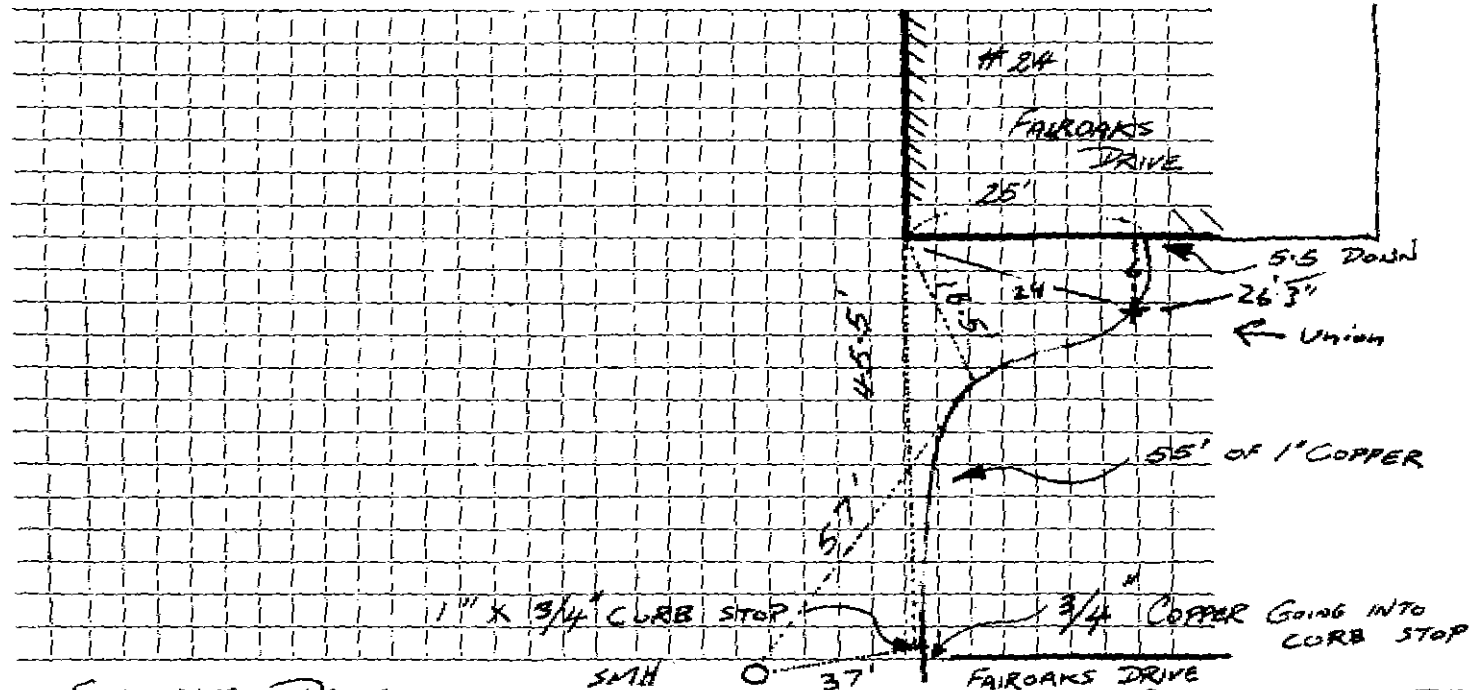

Connection made in FAIROAKS DRIVE Street. SMH Work completed 37' FAIROAKS DRIVE TO OUTLOOK DR.

Remarks: INSPECTED 10-11-'90 BY P. BARROWS CONSTRUCTION BY E. BANKS

1\"/>