

Name C. K. Warren

Service No. ~~10~~ 828

Address 27 Belmont St., W. Everett

Location <sup>#25</sup> Lots #108-109-Fair Oaks Drive

Kind of Pipe

Size

Size of Main

~~Repairs-Renewal~~—New Service

Location

Date	Material	Amount	Total	Date	Amount
12/1	1" C.L. Pipe @ .27	32 67			
7	1" L.L. Coup. @ .25	1 75			
1	1" L.L. Ell	30			
1	1" Br. Nipple	25			
1	S & W	3 00			
	Crucking	1 75			
25	Sticks Dyn. @ .25	6 25			
24	Caps @ .08	1 92	47 89		
3/16/28	101 Hours Labor @ .55	55 55			
34	" " @ .70	23 80			
33	" " @ .65	21 45			
2	Labdr " @ .60	1 20	102 00		
	15% Overhead		15 50		
			165 19		

Mar. 15 1928 - Cash 150 00  
 April 18 1928 - Cash 15 19

Hadley Pipes, Inc., Lexington

Lot # 108-109

DATE 9/8/28

TOWN OF LEXINGTON—BOARD OF PUBLIC WORKS  
WATER DIVISION

The undersigned applies for a supply of water at No. 25 Fair Oaks Drive St. and hereby agrees to comply with the rules and regulations as now, or at any future time, established by the Board of Selectmen.

Am't. of Estimate \$ \_\_\_\_\_

Owner O. W. Warren


Am't. Paid \$ 1.50

Address 27 Belmont St.

Builder M. B. Jenkins

W. Everett

Sketch of Service Here

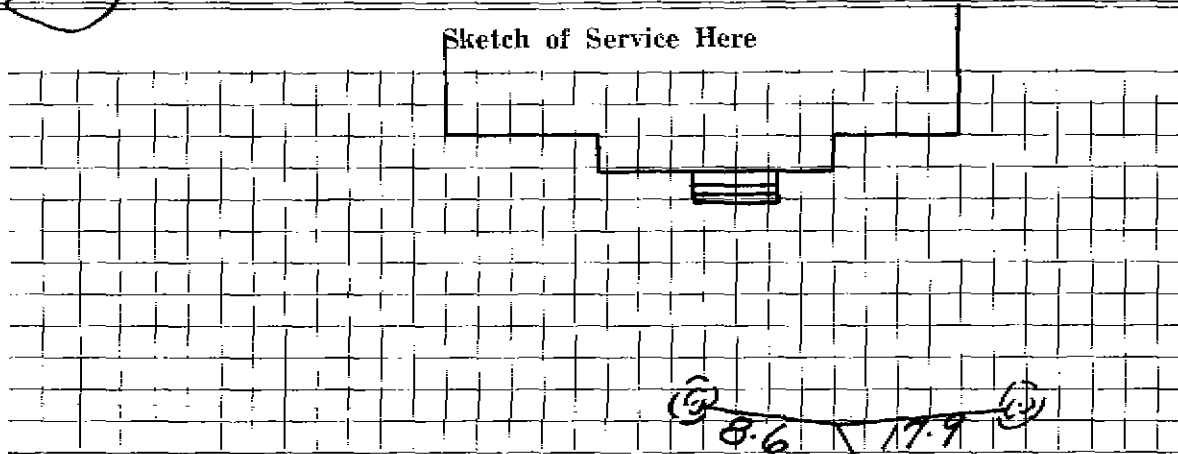

Connection made in \_\_\_\_\_ Street.

Work completed \_\_\_\_\_ 19

Remarks:

30.9