

Name Courtney Comeau
 Address 40 Fair Oaks Drive
 Lexington, Mass.

Service No. 35 #4325

Location 40 Fair Oaks Drive

Kind of Pipe

Size

Size of Main

~~Repair~~ ~~Repair~~ New Service

Com. 5/22/50

Location

Date	Material	Amount	Total	Date	Location	Amount
Apr. 5, '50	Labor	4 90	4 90	<i>Mar 24 '50</i>	<i>Deposited</i>	50 00
	10% Overhead		49	<i>Apr 5 '50</i>	<i>Expended</i>	17 30
	40' - 3/4" Copper Tubing @.23		9 20		No Charge	32 63
	1 - 3/4"C x 1/2" I.W.H. S&W		3 29	Apr. 5, '50	Labor	4 90
	Littlefield Shovel 2 hrs. @7.00	14 00	14 00		26' - 3/4" Copper Tubing @.23	5 98
	Trucking 1 hr. @.75		75		1 - 3/4"C Corp-cock	3 15
			32 63		1 - 3/4" C x 3/4"C Curb-cock	3 85
					1 - Box & Rod	3 70
					1 - 1/2" Straight Tail Piece	38
					1 - 1/2" Offset Tail Piece	38
					Trucking 1 hr. @.75	75
	Labor					23 09

DATE _____

TOWN OF LEXINGTON - BOARD OF PUBLIC WORKS

WATER DIVISION

The undersigned applies for a supply of water at No. St. and hereby agrees to comply with the rules and regulations as now, or at any future time, established by the Board of Selectmen.

Am't of Estimate \$.....

Owner


Am't Paid \$.....

Address

Builder

.....

Sketch of Service Here

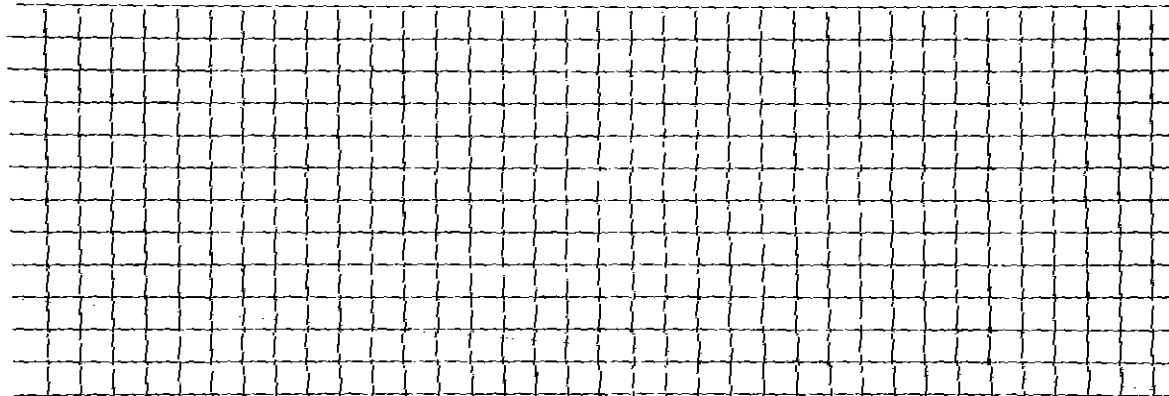

Connection made in Street.

Work completed19

Remarks: