

WATER SERVICE RECORD

#813

Name William Catley

Service No. 17

Address 41 Fair Oaks Drive

Location Lexington, Mass.

~~Report~~ ~~Remove~~ - New Service


Com. 5-212-51

Date	Material	Amount	Total	Date	Amount
2-19-51	Labor	10 00	10 00	Jan 29 51	60 00
	10% Overhead		1 00		
	48' - 3/4" Copper Tubing @.36		17 28		No Charge
	1 - 3/4"C x 1/2" I.W.H. S&W		4 00	2-19-51	Labor 11 20
	Littlefield Shovel 3 hrs. @7.00		21 00		11' - 3/4" Copper Tubing @.36 3 96
	D4 Tractor 2 hrs. @ 3.00		6 00		1 - 3/4"C Corp-cock 4 33
	Trucking 1 hr. @.75		75		1 - 3/4"C x 3/4"C Curb-cock 4 67
			60 03		1 - Box & Rod 4 68
JAN 2004	Relocate 3/4" Copper				1 - 1/2" Offset Tail Piece 50
2	3/4" Unions				1 - 1/2" Straight Tail Piece 50
					Littlefield Shovel 1 hr. @ 7.00 7 00
					Trucking 1 hr. @.75 75
					D4 Tractor 1 hr. @ 3.00 3 00
					40 59

DATE \_\_\_\_\_

TOWN OF LEXINGTON — BOARD OF PUBLIC WORKS  
WATER DIVISION

Sketch of Service Here

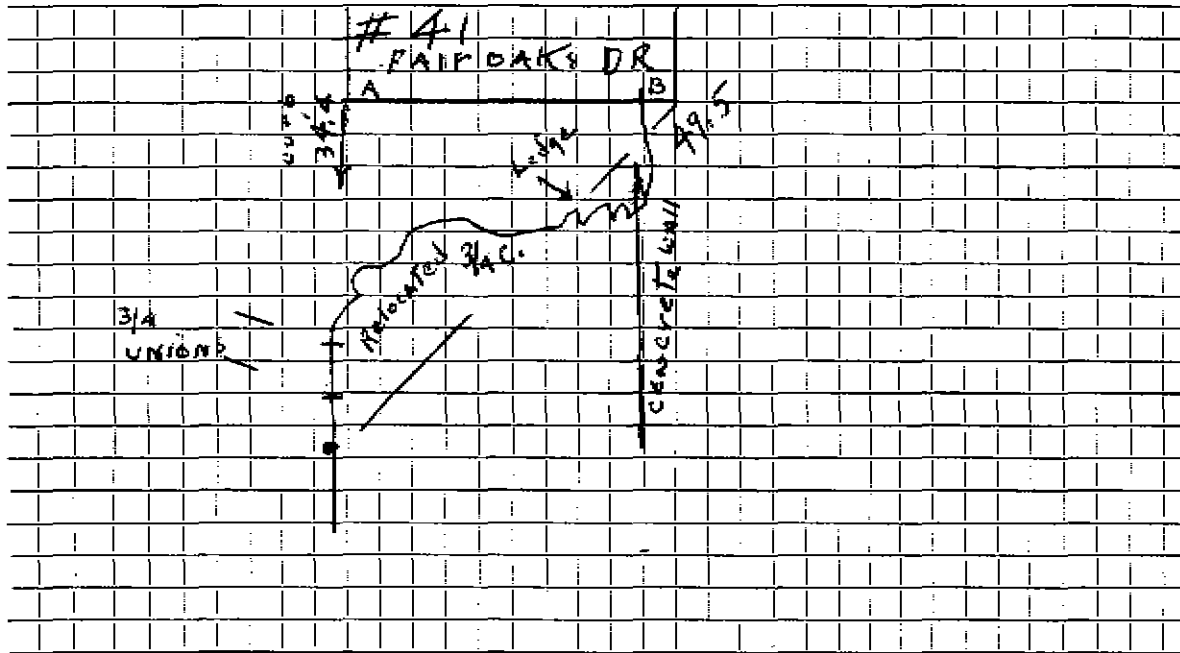

Connection made in \_\_\_\_\_ Street. Work completed \_\_\_\_\_

Remarks: Where water line INTERSECTS with Wall A-19' B-23.6

WATER SERVICE ON ledge

JUNE 2014

Arnold Formano  
RSP Contractors

BOX 412

Concord, MASS

01742


978-369-0053

Relocated  
Water Service

as low as possible

on edge of ledge

House  
#41 Fair Oaks DR  
Lexington, MASS

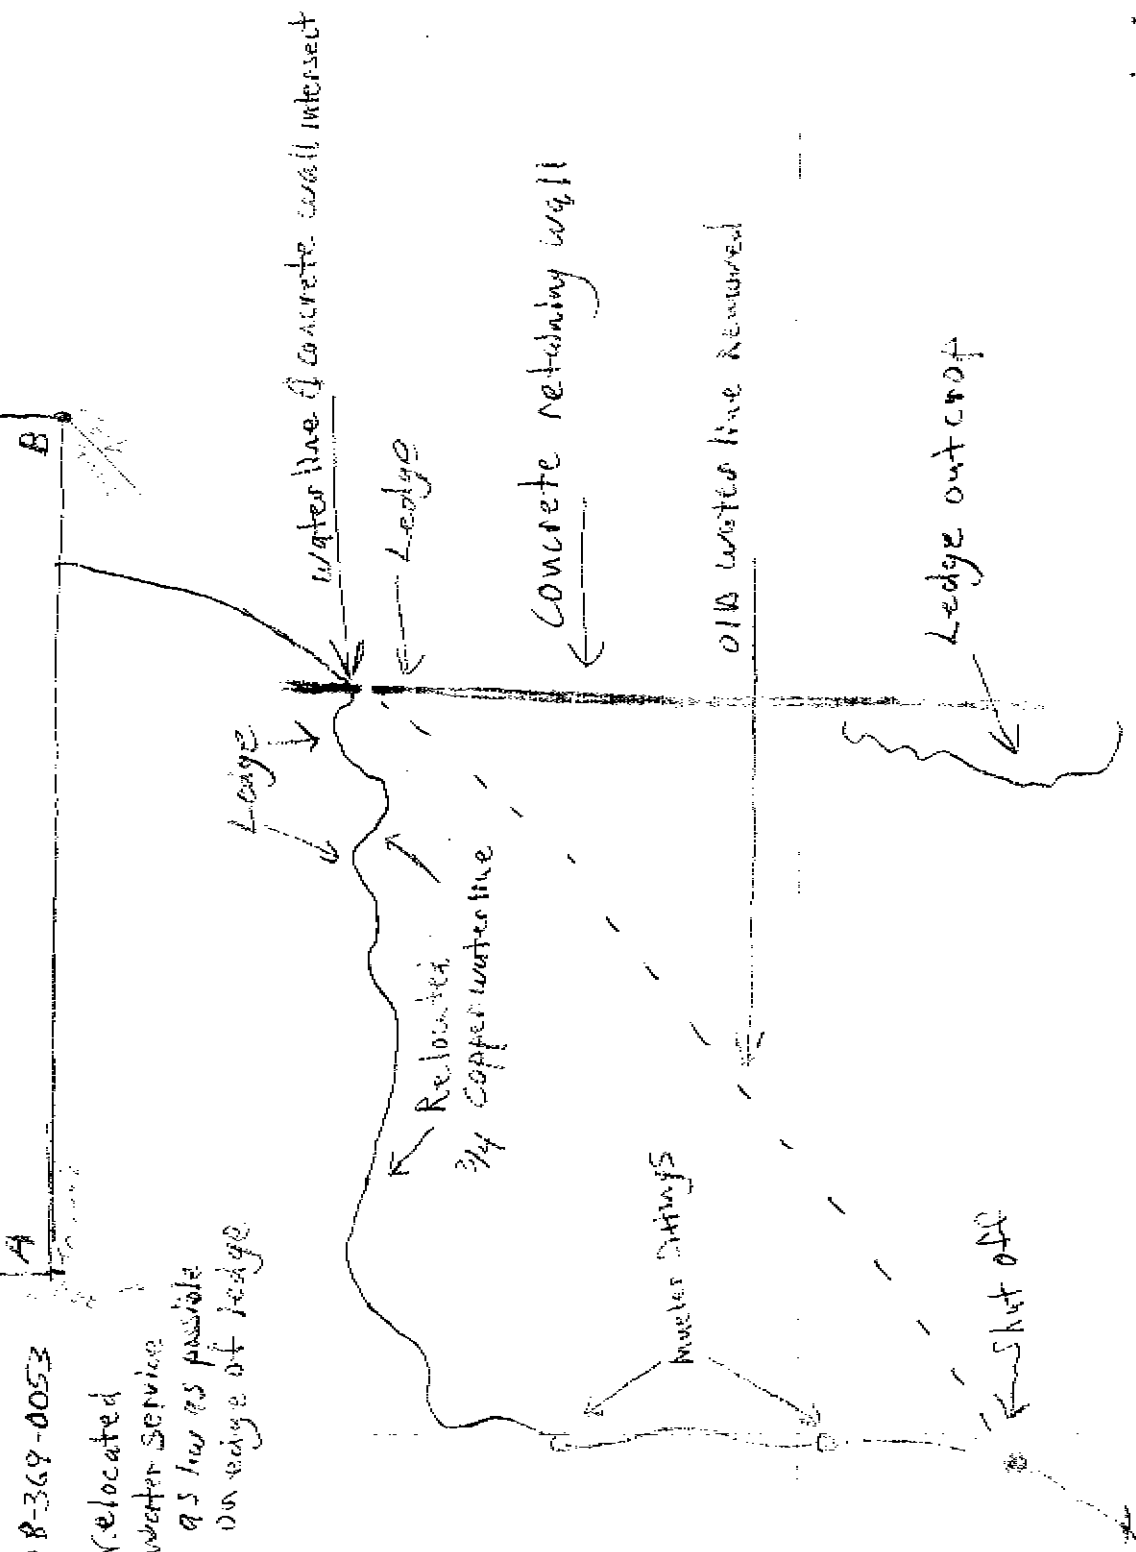

Fair Oaks

A to Start off 34' 4"  
B to Start off 49' 5"

A to where water line of concrete wall intersect 19'

B to where water line of concrete wall intersect 23' 6"