

WATER SERVICE RECORD

#1867

Name Oscar Carlson

Service No. 19

Address 43 Fair Oaks Drive

Location Lexington, Mass.

~~Repair~~ ~~Renewal~~ - New Service


Com. 5-21-51

Date	Material	Amount	Total	Date	Material	Amount
2-19-51	Labor	12 30	12 30	2-19-51	Labor	21 00
	10% Overhead		1 23			
	70' - 3/4" Copper Tubing @.36	25 20	25 20		No Charge	72 20
	1 - 3/4"C x 1/2" I.W.H. S&W	4 00	4 00	2-19-51	Labor	21 00
	1 - 3/4"C x 3/4"C Union (3pts)	1 72	1 72		7' - 3/4" Copper Tubing @.36	2 52
	Littlefield Shovel 3 hrs. @ 7.00	7 00	21 00		1 - 3/4"C Corp-cock	4 33
	D4 Tractor 2 hrs. @ 3.00	6 00	6 00		1 - 3/4"C x 3/4"C Curb-cock	4 67
	Trucking 1 hr. @.75		75		1 - Box & Rod	4 68
			72 20		1 - 1/2" Offset Tail Piece	50
					1 - 1/2" Straight Tail Piece	50
					Littlefield Shovel 1 hr. @ 7.00	7 00
					D4 Tractor 1 hr. @ 3.00	3 00
					Trucking 1 hr. @.75	75
						48 95

DATE _____

TOWN OF LEXINGTON — BOARD OF PUBLIC WORKS
WATER DIVISION

Sketch of Service Here

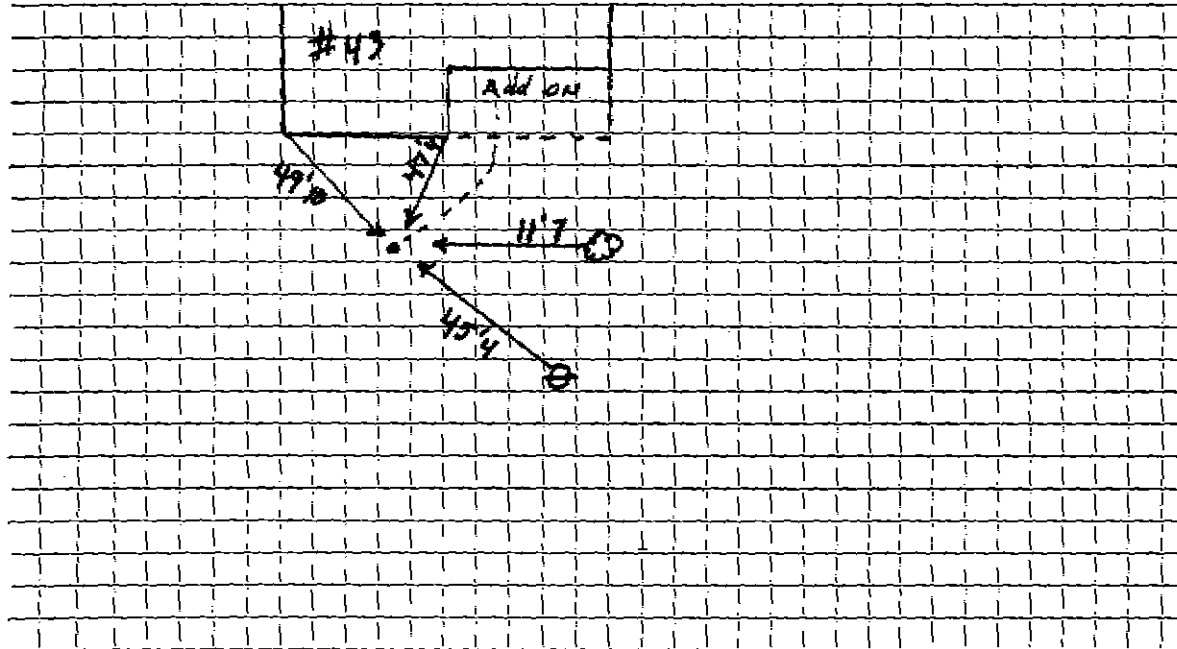

Connection made in Street. Work completed

Remarks:

.....

.....