

WATER SERVICE RECORD

Name Hallett & Brooks

Service No. 16

Address 141 Fair Oaks Drive

#4032

Location Lexington, Mass.

Repair - Renewal - New Service


Com. 5-21-51

Date	Material	Amount	Total	Date	Material	Amount
2-17-51	Labor	20 46	20 46	Jan 29 51	Reputation	60 20
	10% Overhead		2 05	11-29-54	Abated	1 53
	47' - 3/4" Copper Tubing @.36	16 92	16 92		No Charge	61 53
	1 - 3/4" C x 1/2" I.W.F. S&W		1 00	2-17-51	Labor	20 47
	Dynamite 3 lbs. @.24		72	23' - 3/4" Copper Tubing @.36		8 28
	Exploders 6 @ .147		88	1 - 3/4" Corp-cock		4 33
	Compressor 1 hr. @ 1.75		1 75	1 - 3/4" C x 3/4" Curb-cock		4 67
	Littlefield Shovel 2 hrs. @ 7.00		14 00	1 - Box & Rod		4 68
	Trucking 1 hr. @ .75		75	Dynamite 1 lbs. @.24		72
			61 53	Exploders 6 @ .147		88
				1 - 1/2" Straight Tail Piece		50
				1 - 1/2" Offset Tail Piece		50
				Compressor 1 hr. @ 1.75		1 75
				Littlefield Shovel 2 hrs. @ 7.00		14 00
				Trucking 1 hr. @ .75		75
						61 53

DATE _____

TOWN OF LEXINGTON — BOARD OF PUBLIC WORKS
WATER DIVISION

Sketch of Service Here

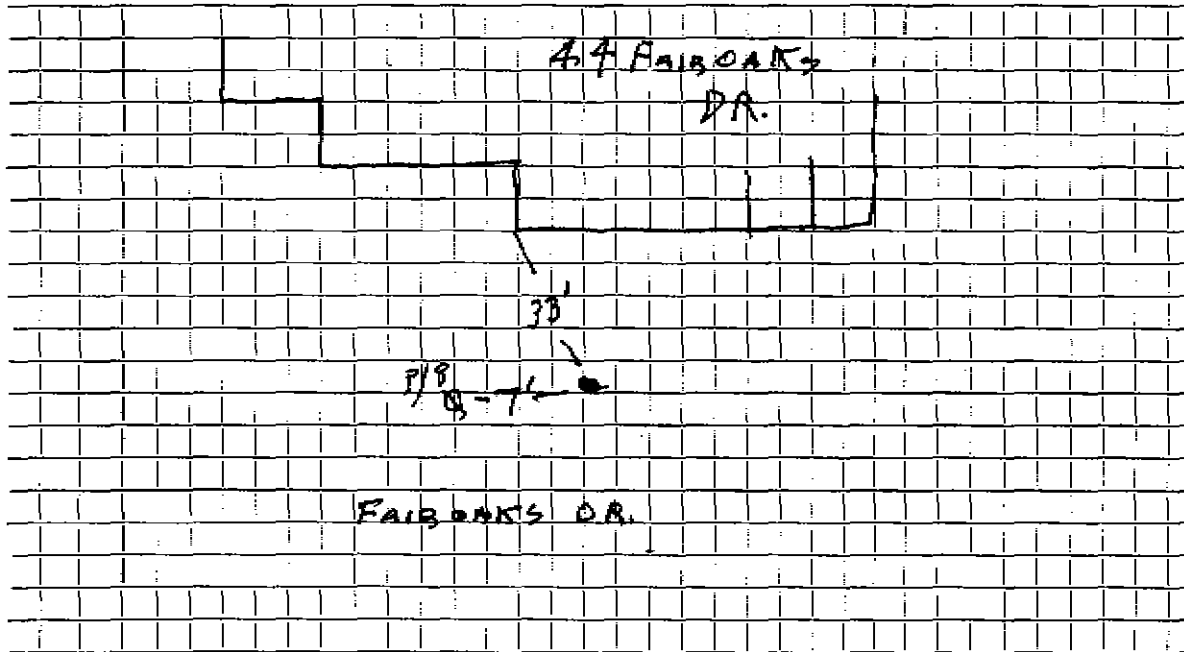

Connection made in Street. Work completed

Remarks:

.....
.....