 

EPR A S	new pres
114	1 10

TOWN OF LEXINGTON — BOARD OF PUBLIC WORKS WATER DIVISION



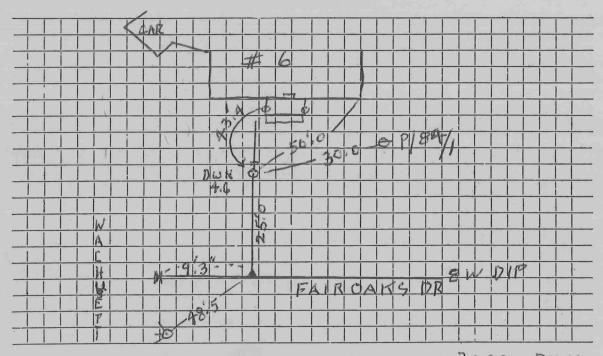

Connection made in Street.	Work completed . 2
Remarks:	

Name

WATER SERVICE RECORD

Service No.

Address 6 FAIR OAKS DR

Location

Repair—Renewal—New Service

Date	Material	Amount	Total	Date	Den 1 2002	Amount
9/11/1936 48	3/4 Copper 1/x3/4" VAILE SALO			Nov-02 25	Demi 2002 I"Copper I"Corp I"Corp I"Corp IX314 Red Boscobox	
	1/23/4" VALUE SALO				1" Corp	
					1" Curb STOP	
					1x314 Red	
			Latina Ph.		Boff lo box	
	1			Lineau Fra		