



Address 15 FAIR OAKS

Location

Repair - Renewal New Service

Date	Material	Amount	Total	Date		A
7/14	1" LAMB BRASS					
	CURB STOP					
	Buffalo Box					
	1" Type K Copper					
	PIPE					

Name Manuel Vincent  
 Address 15 Fair Oaks Terrace  
 Lexington, Mass.

Service No.

# 448

Location 15 Fair Oaks Terrace

Kind of Pipe

Size

Size of Main

~~Repair~~ ~~Renewal~~ New Service

Com. 12-13-49

Location

Date	Material	Amount	Total	Date	Location	Amount
Dec. 6, '49	Labor	10 70	10 70	Nov. 19 '49	Deposited	90 00
	10% Overhead		1 07	Dec. 21 '49	Deposited	7 28
	73' - 3/4" Copper Tubing @.24		17 52		No Charge	62 72
	1 - 3/4" C x 1/2" I.W.H. 58W		3 29	Dec. 6, '49	Labor	40 70
	1 - 3/4" C x 3/4" C Union (3pts)		1 39	12' - 3/4" Copper Tubing @.24		2 88
	Littlefield Shovel 4 hrs. @7.00		28 00	1 - 3/4" C Corp-cock		3 15
	Trucking 1 hr. @.75		75	1 - 3/4" C x 3/4" C Curb-cock		3 85
			62 72	1 - Box & Rod		3 75
				1 - 1/2" Offset Tail Piece		37
				1 - 1/2" Straight Tail Piece		37
				Littlefield Shovel 2 hrs. @7.00		14 00
				Trucking 1 hr. @.75		75
	<b>Labor</b>					69 82

DATE \_\_\_\_\_

TOWN OF LEXINGTON - BOARD OF PUBLIC WORKS

**WATER DIVISION**

The undersigned applies for a supply of water at No..... St. and hereby agrees to comply with the rules and regulations as now, or at any future time, established by the Board of Selectmen.

Am't of Estimate \$.....

Owner .....


Am't Paid \$.....

Address .....

Builder .....

.....

Sketch of Service Here

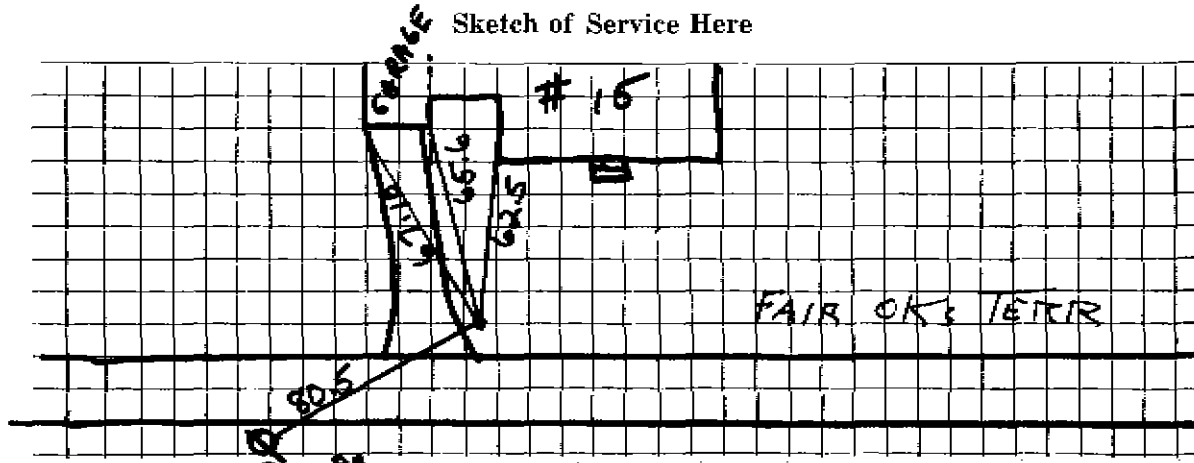

Connection made in ..... Street.

Work completed .....19

Remarks: