

WATER SERVICE RECORD

Name Oscar Carlson

Service No. 143

Address 18 Fair Oaks Terrace

Location Lexington, Mass.

~~Expense Record~~ - New Service Com 7-24-51


Date	Material	Amount	Total	Date	Amount
7-17-51	Labor	4 03	4 03	7-5-51	Deposited 50 00
	10% Overhead		40	9-24-51	Refunded 65
	75' - 3/4" Copper Tubing @.326		24 45		19 35
	1-3/4" Cx 1/2 I.W.H. S&W		4 00		No Charge
	1-3/4" Cx 3/4" C Union (3 pts)		1 72	7-17-51	Labor 61 14
	2 Hrs. Littlefield Shovel		14 00		33' - 3/4" Copper Tubing @.326 10 76
	1 Hr. Trucking		75		1-3/4" C. Corp-Cock 4 33
			49 35		1-3/4" Cx 3/4" C Curb-Cock 4 67
					1 Box & Rod 4 68
					20 Lbs. Dynamite 4 80
					20 Exploders 2 94
					8 Hr. #37 Compressor 14 00
					7 Hr. Littlefield Shovel 49 00
					1-1/2 Offset Tail Piece 50
					1-1/2 Straight Tail Piece 50
					1 Hr. Trucking 75
					158 07

DATE \_\_\_\_\_

TOWN OF LEXINGTON — BOARD OF PUBLIC WORKS

**WATER DIVISION**

Sketch of Service Here

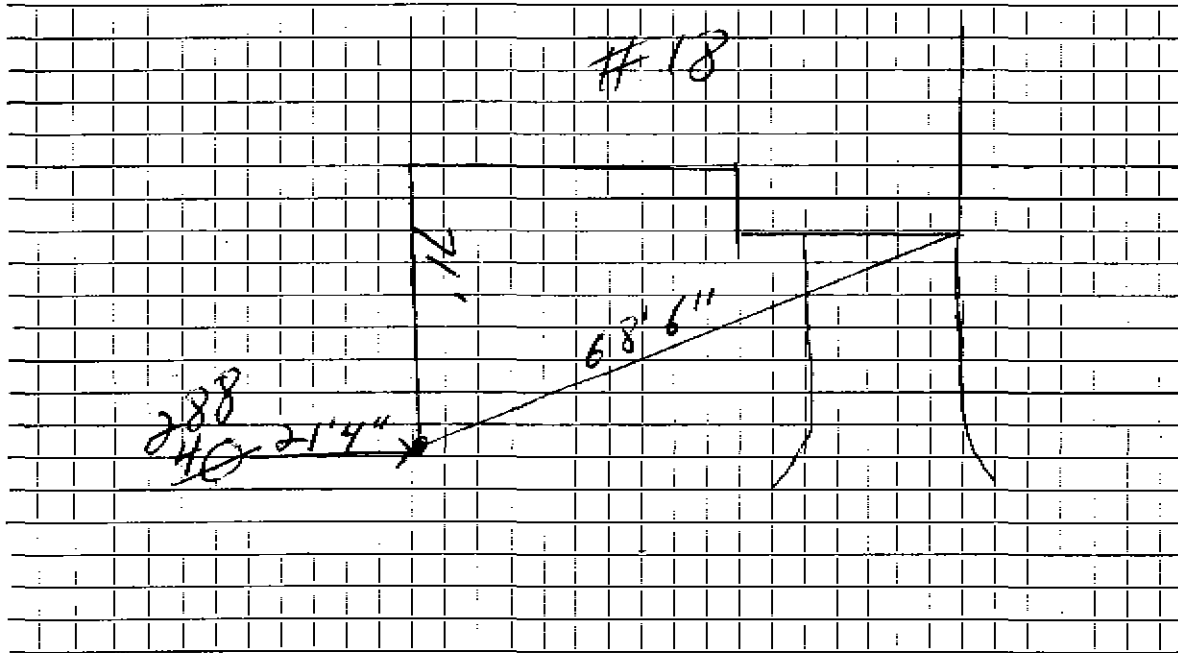

Connection made in ..... Street. Work completed .....

Remarks: .....

.....  
.....