

Name William Potter  
 Address 21 Fair Oaks Terrace  
 Lexington, Mass.

Service \_\_\_\_\_

Location 21 Fair Oaks Terrace

Kind of Pipe \_\_\_\_\_ Size \_\_\_\_\_ Size of Main \_\_\_\_\_

~~Repair~~ ~~Renewal~~ - New Service

*Com. 12-16-46*

Location

Date	Material	Amount	Total	Date	Material	Amount
Oct. 16, '46	Labor	17 87		<i>Jan. 6, '47</i>	<i>Card</i>	47 83
19, '46	"	10 03	27 90			
	10% Overhead		2 79		No-Charge	
	59' - 3/4" Copper Tubing @.23		13 57	Oct. 16, '46	Labor	20 09
	1 - 3" C x 1/2" I.W.H. S & W		2 82	18, '46	"	49 44
	Trucking 1 hr. @.75		75	21' - 3/4" Copper Tubing @.23		4 83
			47 83	1 - 3/4" C Corp-cock		2 70
				1 - 3/4" C x 3/4" C Curb-cock		3 30
				1 - Box & Rod		3 50
				16 Exploders @.11		1 76
				14 lbs. of Dynamite @.12		1 68
				1 - 1/2" Straight Tail Piece		50
				1 - 1/2" Offset Tail Piece		50
				Compressor 6 hrs. @1.75		10 50
				Trucking 1 hr. @.75		75
						99 55

Hadley Press, Inc., Lexington

DATE \_\_\_\_\_

# TOWN OF LEXINGTON—BOARD OF PUBLIC WORKS

## WATER DIVISION

The undersigned applies for a supply of water at No. \_\_\_\_\_ St. and hereby agrees to comply with the rules and regulations as now, or at any future time, established by the Board of Selectmen.


Am't. of Estimate \$ \_\_\_\_\_

Owner \_\_\_\_\_

Am't. Paid \$ \_\_\_\_\_

Address \_\_\_\_\_

Builder \_\_\_\_\_

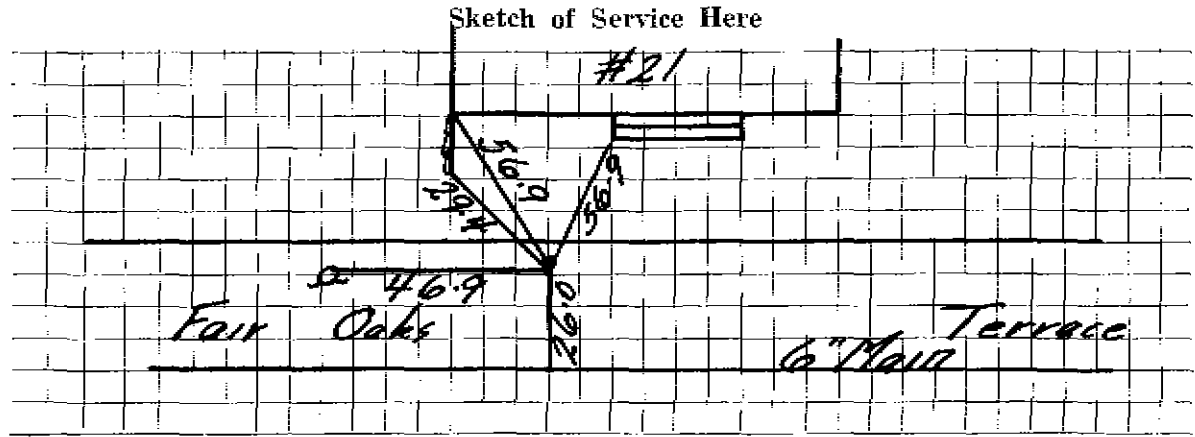

Connection made in \_\_\_\_\_ Street.

Work completed \_\_\_\_\_ 19\_\_

Remarks: