

WATER SERVICE RECORD

Name William Gill

Service No. 125

Address 22 Fair Oaks Terrace

1692

Location Lexington, Mass.


~~Repair Service~~ - New Service *Sum. 7-24-51*

| Date | Material | Amount | Total | Date | Amount |
|---------|---------------------------------|--------|-------|---------------------------------|------------------|
| 7-15-51 | Labor | 8.06 | 8.06 | 6-11-51 | Deposited 100.00 |
| | 10% Overhead | | 81 | 9-24-51 | Refunded 17 |
| | 135'-3/4" Copper Tubing @.326 | | 44.01 | | 91.83 |
| | 1-3/4"Cx3/4" I.W.H. S&W | | 1.00 | | No Charge |
| | 2 3/4Cx3/4"C Union (3 pts) | | 3.44 | 7-17-51 | Labor 28.24 |
| | 2 Bags Rockwool @1.38 | | 2.76 | 30'-3/4" Copper Tubing @.326 | 9.78 |
| | 4 Hrs. Littlefield Shovel @7.00 | 28.00 | 28.00 | 1-3/4"C. Corp-Cock | 4.33 |
| | 1 Hr. Trucking @.75 | | 75 | 1-3/4"Cx3/4"C Gurb-Cock | 4.67 |
| | | | 91.83 | 1-Box & Red | 4.68 |
| | | | | 1-1/2 Offset Tail Piece | 50 |
| | | | | 1-1/2 Straight Tail Piece | 50 |
| | | | | 4 Bags Rockwool @1.38 | 5.52 |
| | | | | 3 Hrs. Littlefield Shovel @7.00 | 21.00 |
| | | | | 1 Hr. Trucking @.75 | .75 |
| | | | | | 79.97 |

DATE _____

TOWN OF LEXINGTON — BOARD OF PUBLIC WORKS
WATER DIVISION

Sketch of Service Here

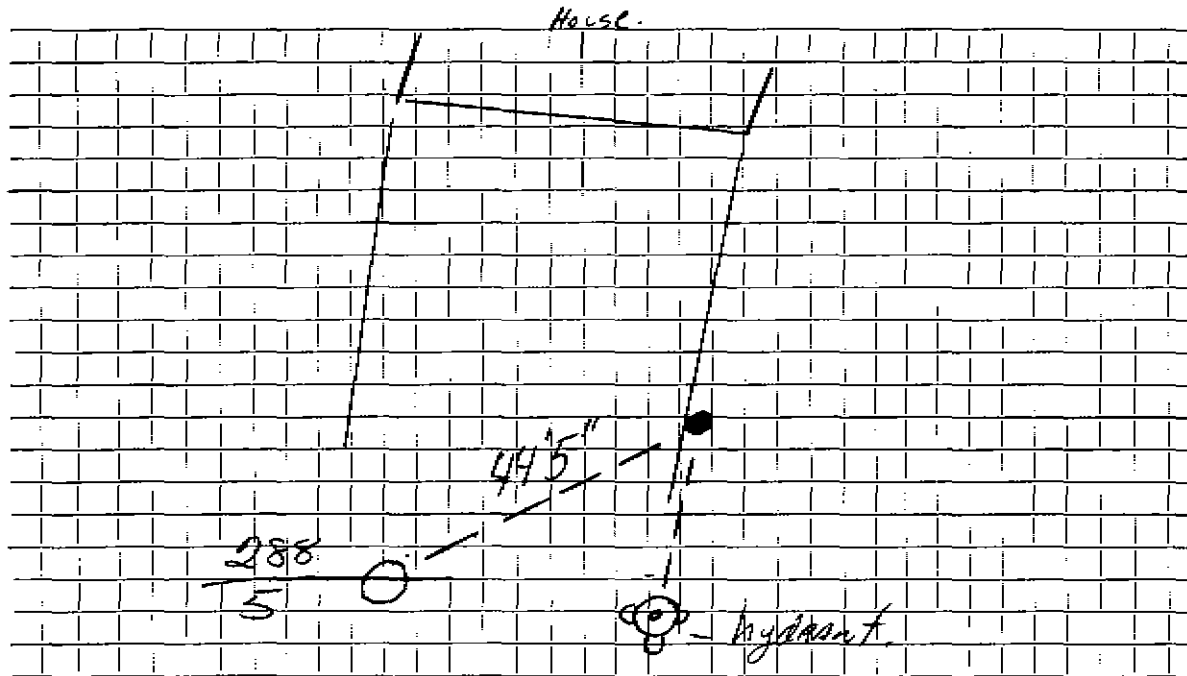

Connection made in Street. Work completed

Remarks:

.....
.....