

WATER SERVICE RECORD

2893

Name William Potter

Service No. 65

Address 24 Fair Oaks Terrace

Location

~~Repair - Renewal~~ New Service W.O. #8065

Comm 10-28-63


| Date    | Material                            | Amount | Total  | Date     | Amount                               |
|---------|-------------------------------------|--------|--------|----------|--------------------------------------|
| 7/17/63 | Labor                               | 44 67  |        | 7-12-63  | Deposit 150 00                       |
|         | 10% Overhead                        | 4 47   | 49 14  | 10-28-63 | Refund 45 79                         |
|         | 52' 3/4" Copper Tubing @ .42        |        | 21 84  |          | 104 21                               |
|         | 1 - 3/4" Cx 1/2 I.W.H. Stop & Waste |        | 6 17   |          |                                      |
|         | 1 - 3/4" C 3-part Union             |        | 2 41   |          | NON CHARGE                           |
|         | 4 bags Rock Wool @ 1.35             |        | 5 40   | 7/18/63  | Labor 20 63                          |
|         | 2 1/2 hrs. Town Shovel @ 6.50       |        | 16 25  |          | 24' - 3/4" Copper Tubing @ .42 10 08 |
|         | 1 hr. Trucking                      |        | 3 00   |          | 1 - 3/4" C, Corp Cock 4 91           |
|         |                                     |        | 104 21 |          | 1 - 3/4" C, Curb Cock 6 28           |
|         |                                     |        |        |          | 1 Box & Rod 4 90                     |
|         |                                     |        |        |          | 1 - 1/2 Straight Tailpiece 50        |
|         |                                     |        |        |          | 1 - 1/2 Offset Tailpiece 50          |
|         |                                     |        |        |          | 1 1/2 hrs. Town Shovel @ 6.50 9 75   |
|         |                                     |        |        |          | 57 55                                |

DATE \_\_\_\_\_

TOWN OF LEXINGTON — BOARD OF PUBLIC WORKS

WATER DIVISION

Sketch of Service Here

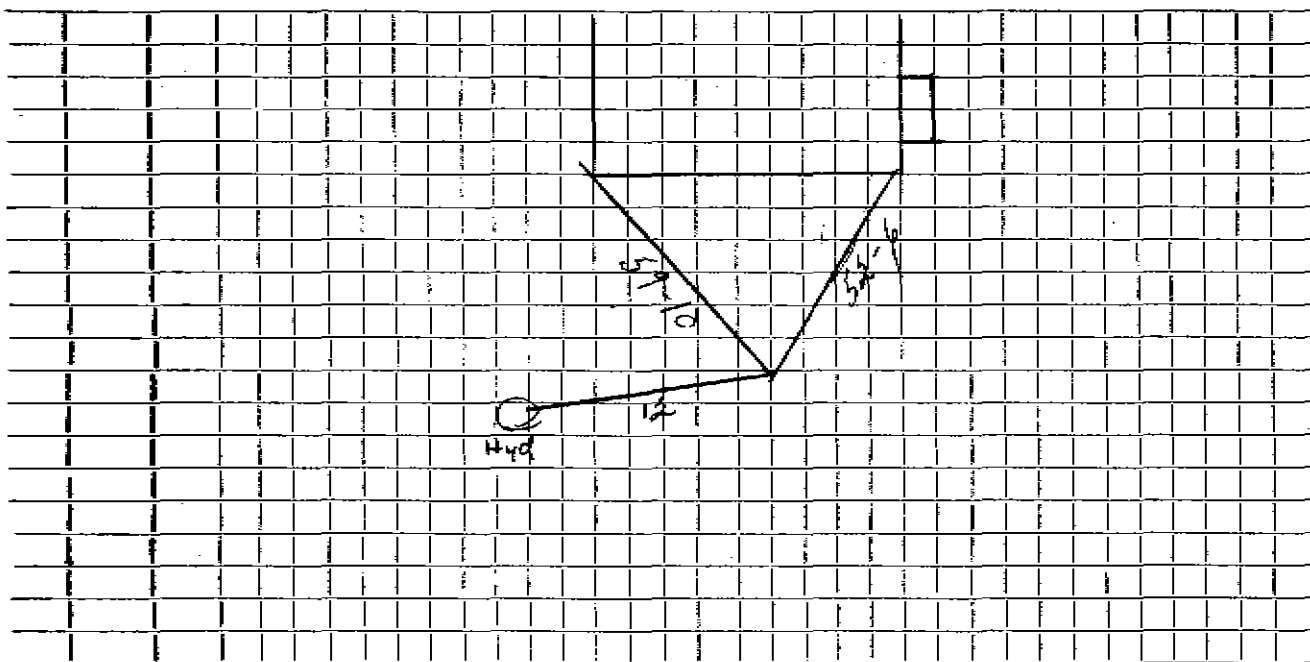

Connection made in . . . . . Street. Work completed . . . . .

Remarks: . . . . .  
. . . . .  
. . . . .