

Name Oscar Carlson

Service No. 190

Address 6 Fair Oaks Terrace
Lexington, Mass.

6664

Location 6 Fair Oaks Terrace

Kind of Pipe

Size

Size of Main

~~Repair - Renewal~~ - New Service

Com. 11-6-50

Location

Date

Material

Amount

Total

Date

Amount

Aug. 19, '50

Labor

3 80

3 80

July 22 '50

Revised

40 00

10% Overhead

33

50' - 3/4" Copper tubing @.275

13 75

No Charge

37 26

1 - 3/4" C x 1/2" I.W.R. S&W

3 29

Aug. 19, '50

Labor

8 95

1 - 3/4" C x 3/4" C Union (3pts)

1 39

1 1/2' - 3/4" Copper Tubing @.275

3 85

Littlefield Shovel 2 hrs. @7.00

14 00

1 - 3/4" C Corp-cock

3 15

Trucking 1 hr. @.75

75

1 - 3/4" C x 3/4" C Curb-cock

3 85

37 36

1 - Box & Rd

3 35

1 - 1/2" Offset Tail Piece

42

1 - 1" Straight Tail Piece

42

Littlefield Shovel 2 hrs. @ 7.00

14 00

Trucking 1 hr. @.75

75

Labor

38 74

TOWN OF LEXINGTON—BOARD OF PUBLIC WORKS

WATER DIVISION

The undersigned applies for a supply of water at No. _____ St. and hereby agrees to comply with the rules and regulations as now, or at any future time, established by the Board of Selectmen.

Am't. of Estimate \$ _____


Owner _____

Am't. Paid \$ _____

Address _____

Builder _____

Sketch of Service Here

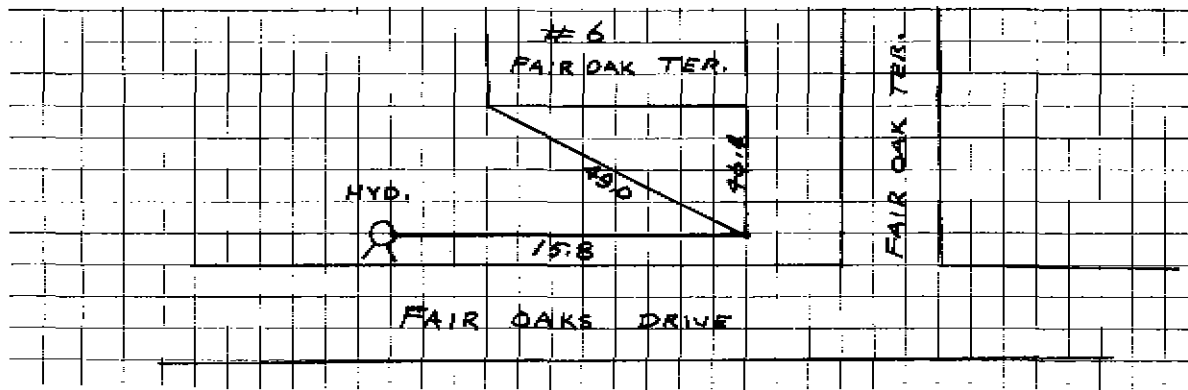

Connection made in _____ Street.

Work completed _____ 19__

Remarks: