WATER SERVICE RECORD


Name		Home Realty			Service No.			
Add	Address 7 Fair Oaks Terrace							
	ation	, 1411 (4)15 1011						
		770 Danie						
кер	air—Ke	enewal-New Service	E.R. Banks #00	10				
Date		Material	Amount	Total	Date	Amount	Amount	
9/28/90	47	l" Copper						
	Ī							
	-	··	_ _	i i				
	·	·		 	- 			
	_} _ _	 _	_ -	<u> </u>	- 	-		
	╌┼╼╌┤			 				
		·	_ '	j	- 			
	_i		_	<u> </u>	<u>" ' </u>			
	· ·		: ! 	<u> </u>	<u> </u>		— <u>–</u>	
	,			<u>'</u>				
	†		_ 	i				
					· '			
	+			 -				
_			╌┟╌╼╌╴┼	ļ	- 			
	 			 -	 · - ·			
- 	· .		· 	 	_ !	· · · · ·		
	<u> </u>			<u> </u>	-ii	' '-		
	[:	·	,		
				<u> </u>				
	 :				-			
				 	 			

DATE 9/28/89

TOWN OF LEXINGTON - BOARD OF PUBLIC WORKS

WATER DIVISION

Sketch of Service Here

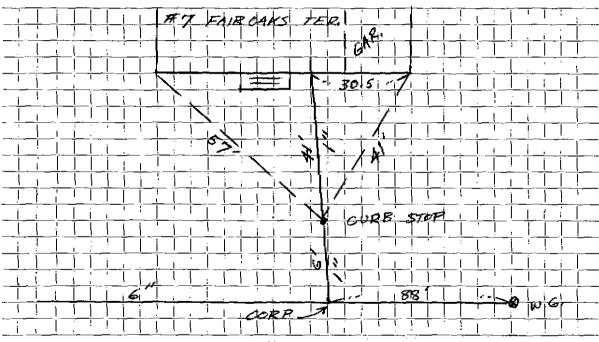

Connection made in	Street.	Work completed
Remarks: . INSP. CRG		