

WATER SERVICE RECORD

Name Lot 34 Anthony DiGiovanni

Service No. 259

Address 10 Fairbanks Road

Location

Repair ~~Renewal~~ - New Service SERVICE IN TO CURB

Comm 3-16-59


Date	Material	Amount	Total	Date	Amount
11-21-58	Labor	12.81		11-21-58	50.00
	10% O.H.	1.28	14.09	3-16-59	7.84
58	3/4" Copper tubing @.37		21.46		NON CHARGE
1	3/4" C x 1/2 I.W.H. Stop & Waste	5.84		7/8/54	Labor
1	hr. Trucking @.75	.75		25'	3/4" Copper tubing@.35
			42.14	1	3/4" C. corp-cock
				1	3/4" C x 3/4" C. curb-cock
				1	box and rod
				1	hr. trucking
					75
					26.57
				1	1/2 Offset tailpiece
				1	1/2 Straight Tailpiece
					.50
					.50
					27.57

DATE \_\_\_\_\_

TOWN OF LEXINGTON — BOARD OF PUBLIC WORKS

**WATER DIVISION**

Sketch of Service Here

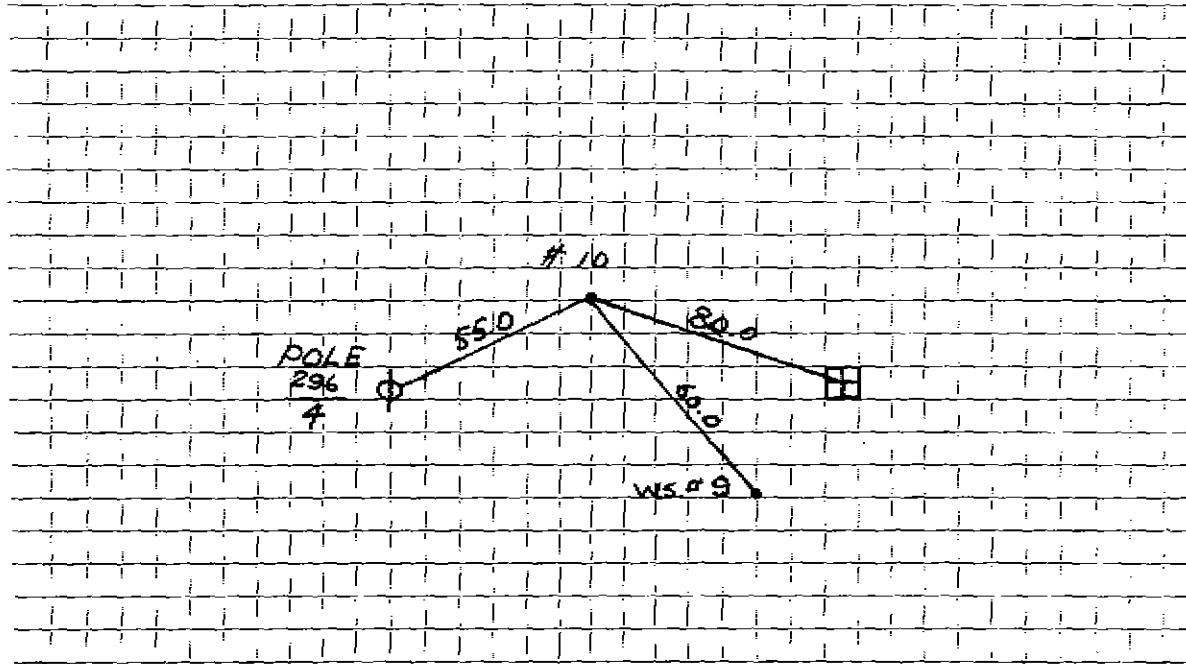

Connection made in ..... Street. Work completed .....

Remarks: .....

.....

.....