




Date: 3/4/24

TOWN OF LEXINGTON - BOARD OF PUBLIC WORKS  
WATER DIVISION

SKETCH OF SERVICE HERE  
15 Fairbanks Rd

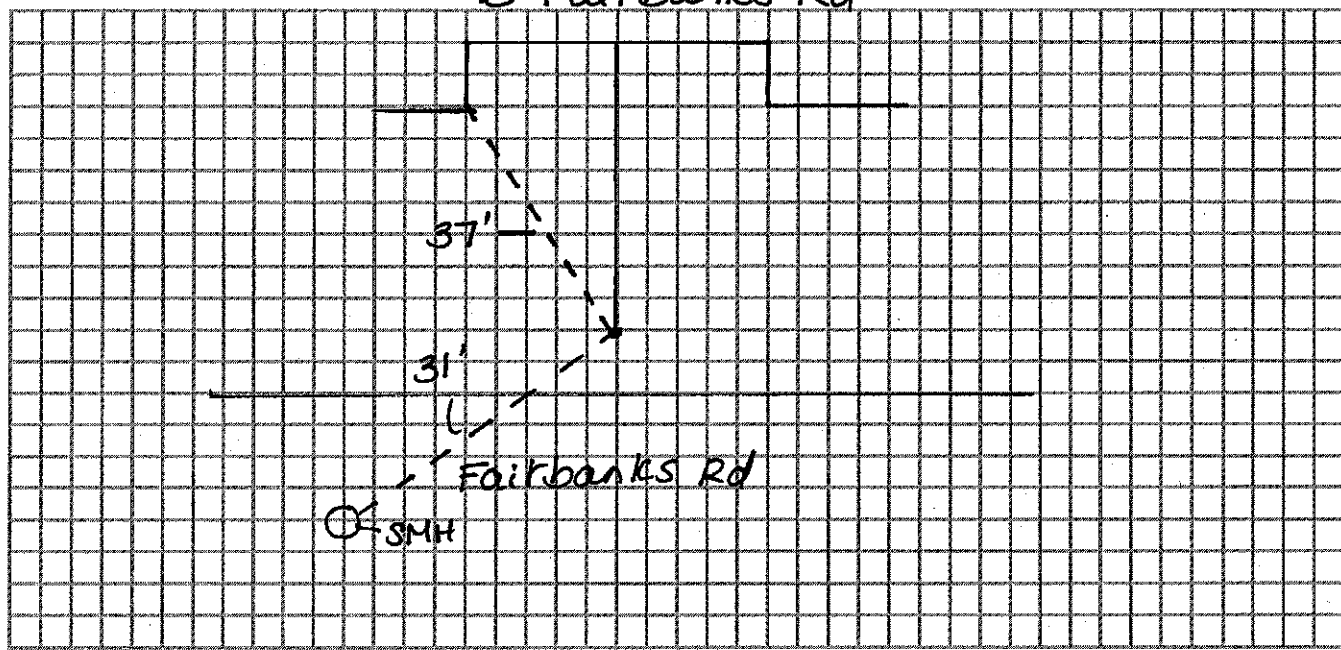

Connection made in:

Street:

Work completed:

Remarks: Installed by AM Ratta Corp.