

WATER SERVICE RECORD

Name Joseph P. Spinelli

Service No. 338

Address 16 Fairbanks Road

Location

~~Repair~~ ~~Renewal~~ New Service

Com. 12-31-55


Date	Material	Amount	Total	Date	Amount
11/26/55	Labor	7.00		10-18-55	Deposited \$ 75.50
	10% overhead	7.00	8.11	12-31-55	Refunded (19.03)
	1 - 3/4" Copper tubing @ 1.56	24.08			NON CHARGE 53.97
	1 - 3/4" x 1/2" I.W.F. Stop & Waste	4.00		1 - 3" straight tail piece	50
	1 hr. trucking	1.75		1 - 3" offset tail piece	50
	2 hrs. Littlefield Shovel @ 9.50	19.00			NON CHARGE 1.00
			55.97	7-9-54	25' 3/4" Copper Tubing
					1 3/4" C. Corp. Cock
					1 3/4" C x 3/4" C. Curb Cock
					1 Box & Rod

DATE \_\_\_\_\_

TOWN OF LEXINGTON — BOARD OF PUBLIC WORKS

**WATER DIVISION**

Sketch of Service Here

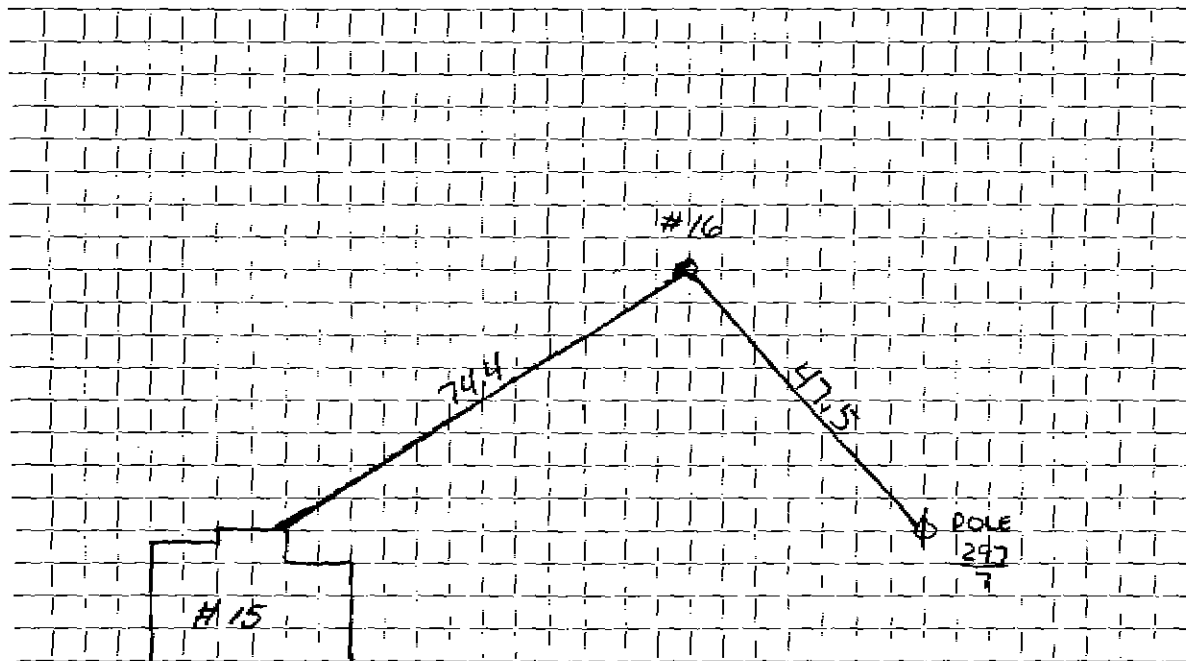

Connection made in ..... Street. Work completed .....

Remarks: .....

.....

.....