

WATER SERVICE RECORD

Service No. 209

Name Eugène Roberts

Address 18 Fairbanks Road

8790

Location

Repair—Renewal—New Service

Comm. 10-8-56


Date	Material	Amount	Total	Date	Amount	
7/24/56	Labor	7 10		7-12-56	Deposit	50 00
	10% Overhead	71	7 81	10-8-56	Refund	08
	40' 3/4" Copper tubing @ .4850		19 40			49 92
	1 3/4" C x 1/2" I.W.H. Stop & Waste		4 96	12-31-56	Abated & Refunded	17 00
	1 hr. trucking		75		NON CHARGE	32 92
	2 hrs. Littlefield @ 8.50		17 00		1 1/2 Straighttail Piece	50
			49 92		1 1/2 Offset " "	50
	12-31-56 Abated		17 00	7-9-54	NON CHARGE	1 00
			32 92		25' 3/4" Copper Tubing	
					1 3/4" C. corp cock	
					1 3/4" C x 3/4" C. curb cock	
					1 Box of Rod	

DATE _____

TOWN OF LEXINGTON — BOARD OF PUBLIC WORKS

WATER DIVISION

Sketch of Service Here

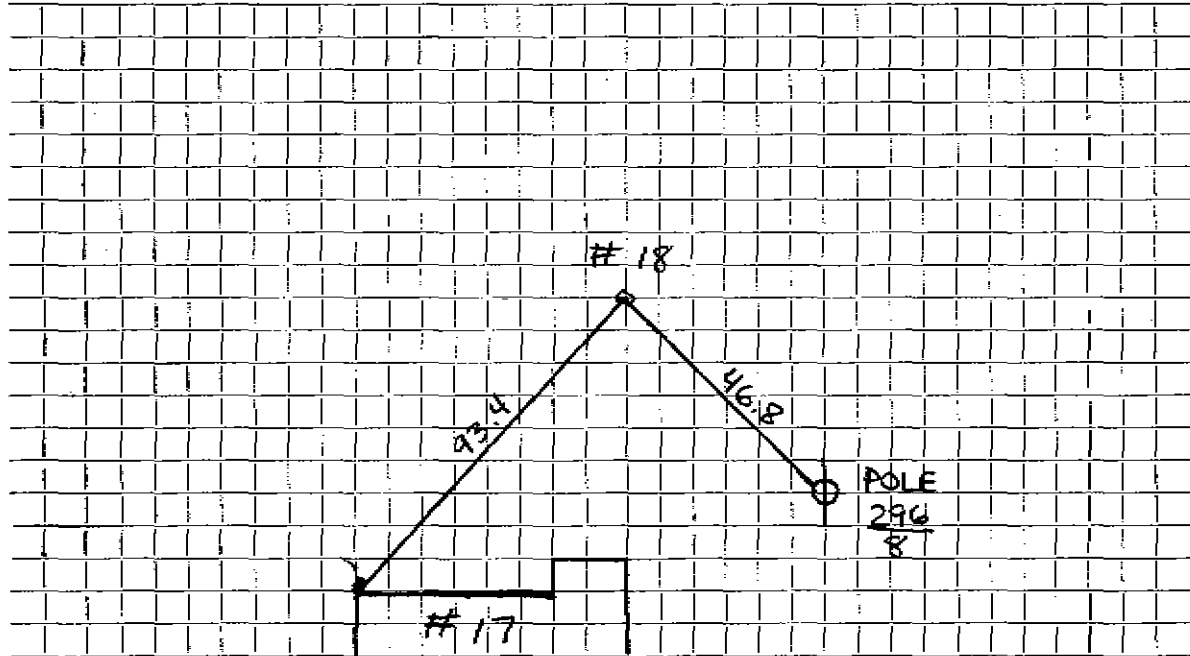

Connection made in Street. Work completed

Remarks:

.....

.....