


TOWN OF LEXINGTON - BOARD OF PUBLIC WORKS

WATER DIVISION

Date: 4/21/21

SKETCH OF SERVICE HERE

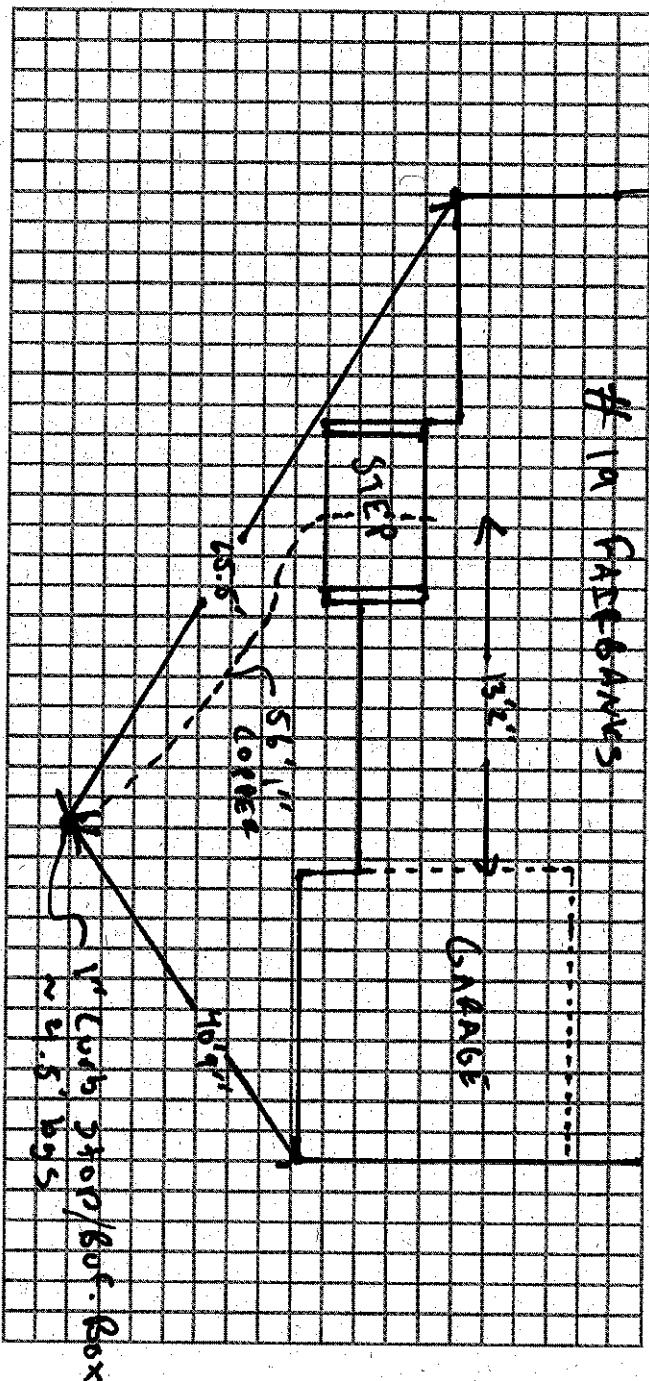

Connection made in: FARNBANKS Rd Street. Work completed: WATER LINE  
Remarks:

## Water Service Record

Name McLaughlin, JAMES M INC

Laughlin, James M  
Fairbanks Team

## Location

Repair - Renewal - New Service

Service No. **WF21-20**

Service No. **WF21-20**

**WATER SERVICE RECORD**

Name Henry Moulton

Service No. 391 n.d.

**Address** 19 Fairbanks Road

# 2166

### **Location**

#### **Repair—Renewal—New Service**

SERVICE WAS IN TO CURB:  
COPPER SUPPLIED BY OWNER:


Conn. 12-19-58

Date	Material	Amount	Total	Date	Amount
11/5/55	Labor	1 85			
	10% overhead	19	2 04	11-28-55 Paid	8.51
	1 - 3/4" C x 1/2 I.W.H. stop & waste	4.00			NCM CHARGE
	1 - 3/4" C x 3/4" C. coupling	1.72	1 - 1/2 straight tail piece		50
	1 hr. trucking	1.75	1 - 1/2 offset tail pc.		50
		8.51			1.00
				7-9-54 10' 3/4" Copper Tubing	
				1 3/4" C. corp-coat	
				1 3/4" C x 3/4" C curb-coat	
				1 Box & Bod	

DATE \_\_\_\_\_

TOWN OF LEXINGTON — BOARD OF PUBLIC WORKS  
WATER DIVISION

Sketch of Service Here

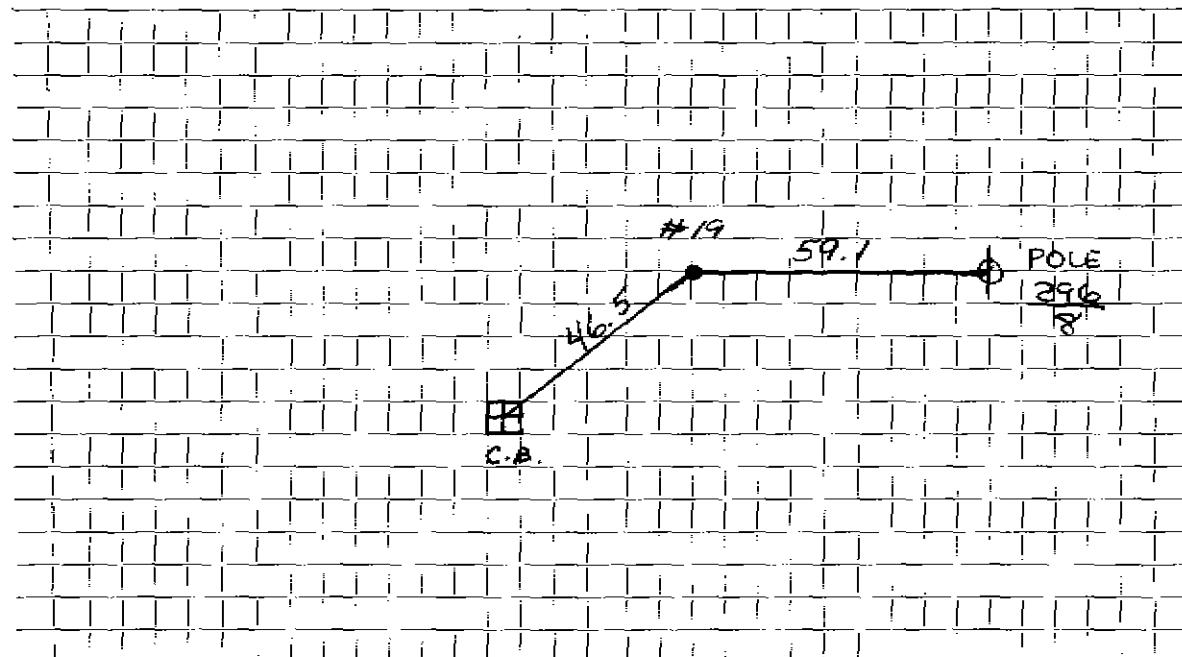

Connection made in ..... Street. Work completed .....

Remarks: .....

.....  
.....