

WATER SERVICE RECORD

#4952

Name Henry J. Moulton, Jr.

Service No. 66

Address 20 Fairbanks Road

Location

~~Repair & Renewal~~ - New Service

Service in to curb


Date	Material	Amount	Total	Date	Material	Amount
4/56	Labor	1 95		4-9-56	Deposit	\$ 35 00
	10% overhead	20	2 15	8-6-56	Refund	5 31
	45' 3/4" Copper tubing @ .4850	4850	21 83		NON CHARGE	29 69
	1 - 3/4" Cx 1/2" I.W.H. Stop & Waste		4 96	4-56	1 - 1/2" Straight tailpiece	50
	1 hr. trucking		75		1 - 1/2" Offset tailpiece	50
			29 69	7-9-54	22' 3/4" Copper tubing	1 00
					1 3/4" C. corp-cock	
					1 3/4" C x 3/4" C curb-cock	
					1 Box & Rod	

DATE _____

TOWN OF LEXINGTON — BOARD OF PUBLIC WORKS

WATER DIVISION

Sketch of Service Here

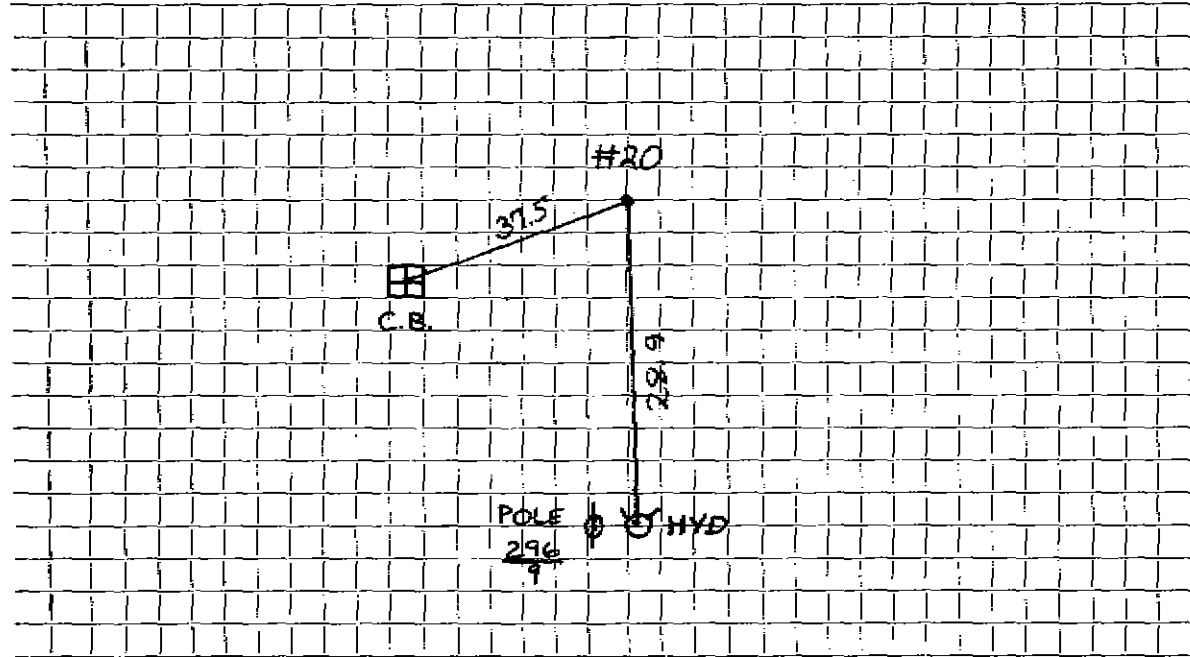

Connection made in Street. Work completed

Remarks:
.....
.....