

WATER SERVICE RECORD

Name Henry Moulton

Service No. 392 n.d.

Address 21 Fairbanks Road

Location

~~Repair~~ ~~Overhaul~~ - New Service

Comm. 12-19-55

Date	Material	Amount	Total	Date	Amount
10/5/55	Labor	1 85			
	10% overhead	19	2 04	12-28-55	
	1 - 3/4" C x 1/2 I.W.H. stop & waste		4 00		
	1 hr. trucking		75		
			6 79		
	SERVICE WAS IN TO CURB:			7-9-54	
	OWNER SUPPLIED OWN COPPER:			10' 3/4" Copper tubing	1 00
				1 3/4" C. corp-cock	
				1 3/4" C. x 3/4" C. curb-cock	
				1 Box & Rod	

No Deposit
paid

NON CHARGE


1 - 1/2 straight tail pc. 50
1 - 1/2 offset tail pc. 50

DATE _____

TOWN OF LEXINGTON — BOARD OF PUBLIC WORKS

WATER DIVISION

Sketch of Service Here

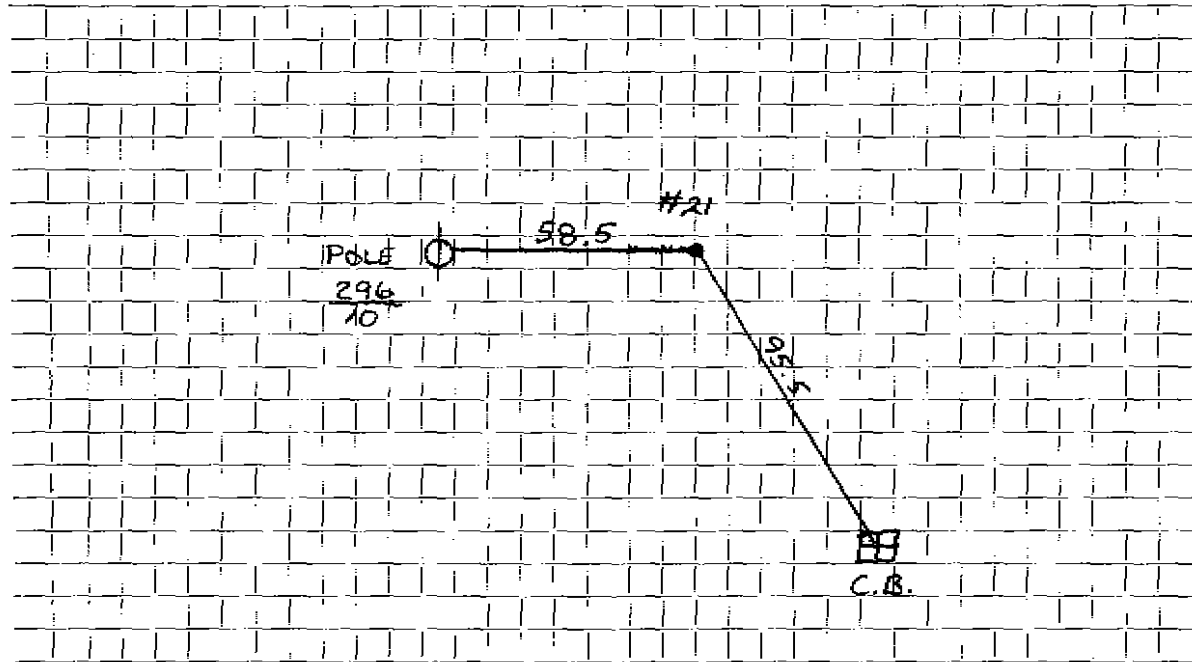

Connection made in Street. Work completed

Remarks:
.....
.....