


DATE 10-27-2001

TOWN OF LEXINGTON — BOARD OF PUBLIC WORKS
WATER DIVISION

Sketch of Service Here

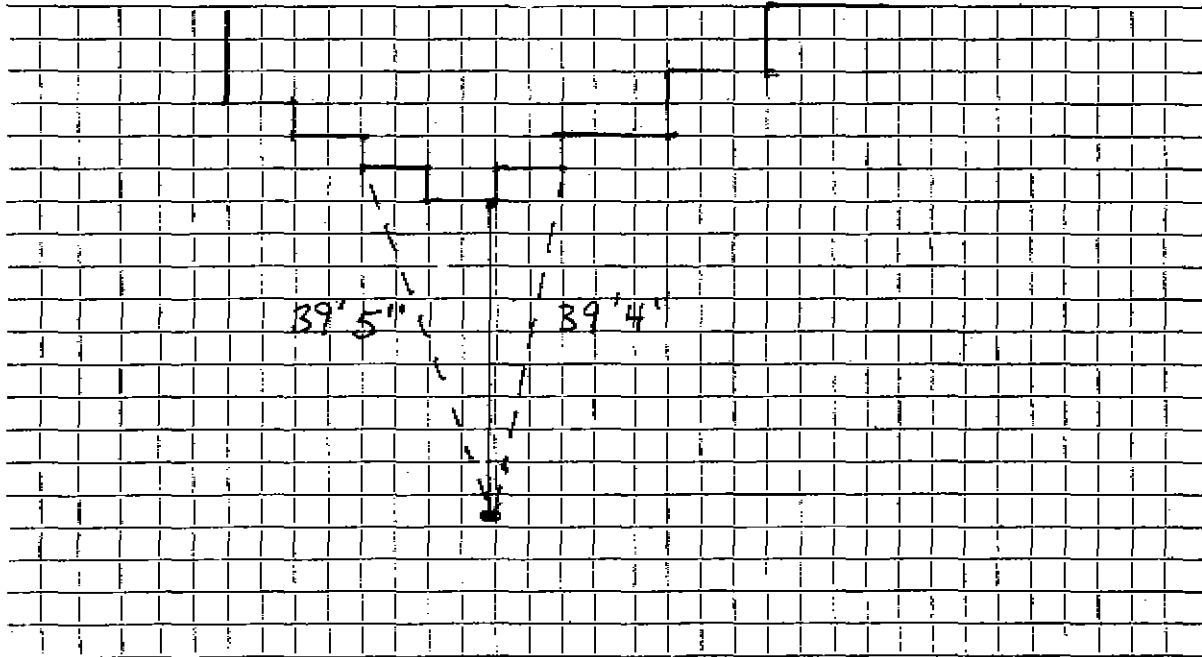

Connection made in ... FAIRBANKS Rd Street. Work completed ... 10-27-2001

Remarks: INSTALLED BY CANNIZZO BRO.