

WATER SERVICE RECORD

Name Roger P. Swanson

Service No. 136

Address 23 Fairbanks Road

Location

~~Repair~~ ~~Renewal~~ — New Service

*Cam 7-18-55*

Date	Material	Amount	Total	Date	Amount
5/3/55	Labor	10 10		5-17-55	60 00
	10% overhead	1 01	11 11	7-18-55	7 52
	45' - 3/4" copper tubing @ .3693	16 62			52 48
	1 - 3/4" O x 3/8 I.W.H. stop & waste	1 00			
	2 2/3 hrs. Littlefield shovel @ 7.50	20 00			
	1 hr. trucking	75			
		52 48		7-9-54	10' 3/4" Copper tubing
					1 3/4" C. corp-cock
					1 3/4" C x 3/4" C curb-cock
					1 Box & Rod

*Deposited*

*Refunded*

NET CHARGE

SERVICE WAS IN TO CURB:

1 - 3/8 straight tail piece 50


1 - 3/8 offset tail piece 50

DATE \_\_\_\_\_

TOWN OF LEXINGTON — BOARD OF PUBLIC WORKS

**WATER DIVISION**

Sketch of Service Here

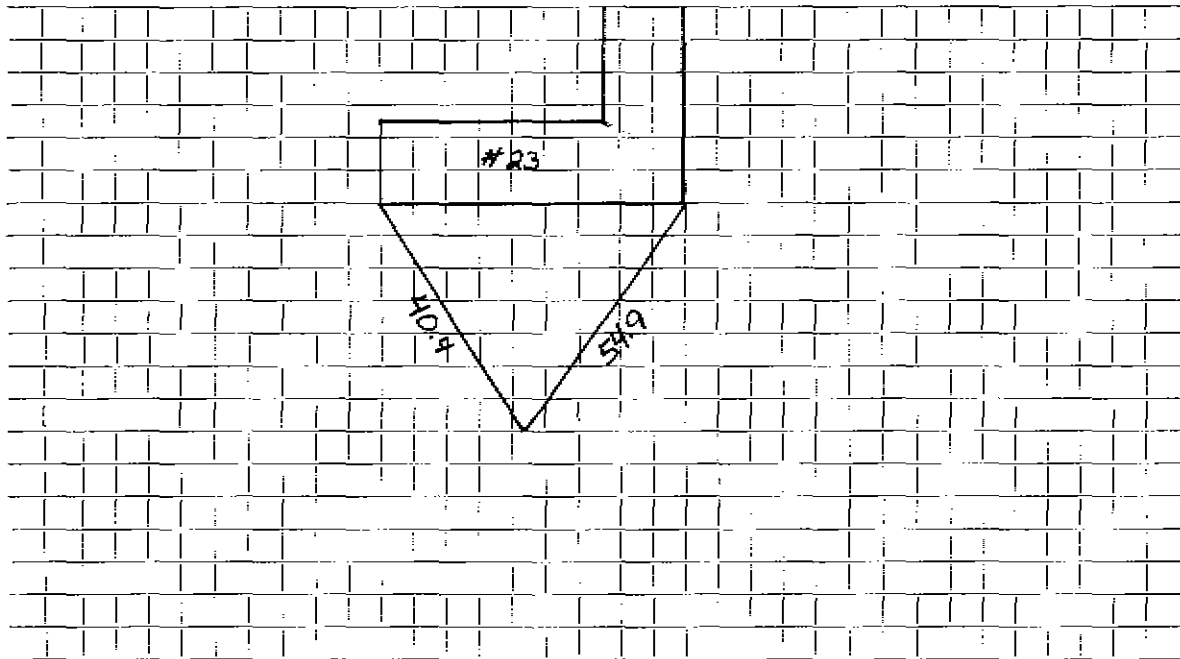

Connection made in ..... Street. Work completed .....

Remarks: .....

.....

.....