


DATE _____

TOWN OF LEXINGTON — BOARD OF PUBLIC WORKS

WATER DIVISION

Sketch of Service Here

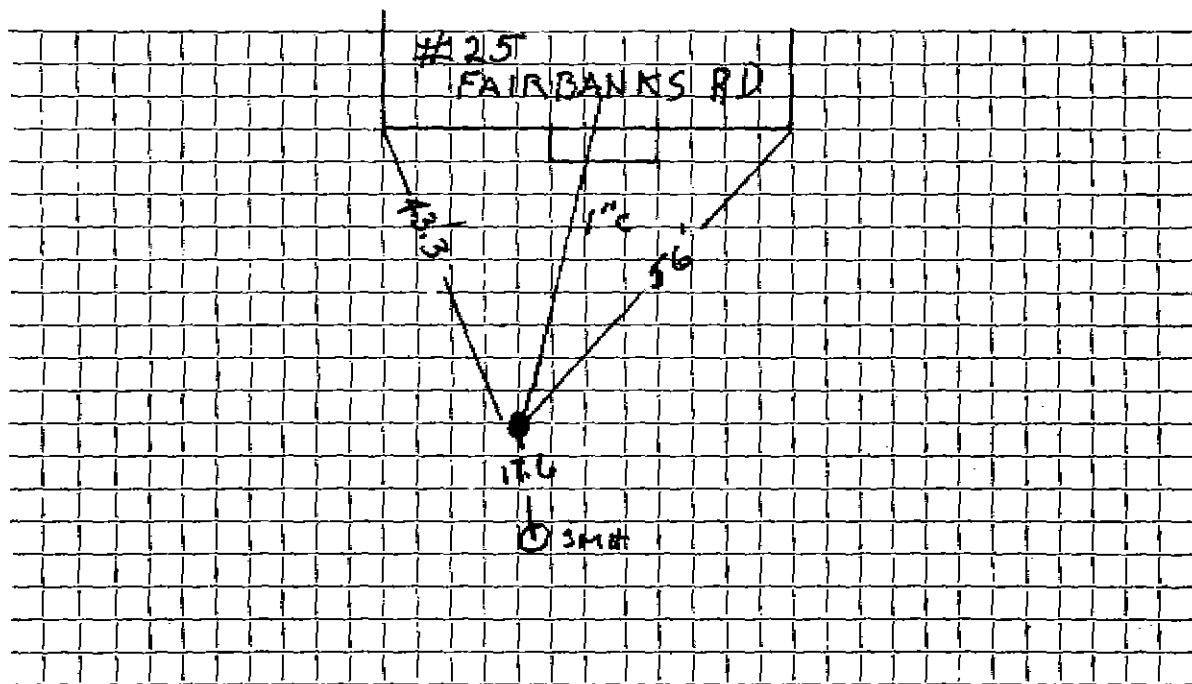

Connection made in Street. Work completed

Remarks: INST. NEW 3/4" CURB STOP (DID NOT LOCATE OLD CURB STOP) 6/22/99