

WATER SERVICE RECORD

5785

Name

Service No. # 5785

Address 27 Fairbanks Road

Location

~~Repair Work~~—New Service W.O. # 81


Date	Material	Amount	Total	Date	Amount
4-4-65	Labor	68 22		7-6-54	10' 3/4" Copper tubing
	10% O.H.	6 82	75 04	1	3/4" C. corp-cock
	10' 3/4" copper tubing @ .42		4 20	1	3/4" C. x 3/4" C. curb-cock
1	3/4" Corp.		7 42	1	Box & Rod
1	3/4" Curb.		8 76		
1	Box & Rod		4 90		
	21 x 3 Patch		21 00		
4	Hrs. Town Shovel @ 6.50		26 00		
2	Hrs. Town Truck @ 3.00		6 00		
			153 31		
4-13-65	36' 3/4" Copper tubing				

DATE _____

TOWN OF LEXINGTON — BOARD OF PUBLIC WORKS

WATER DIVISION

Sketch of Service Here

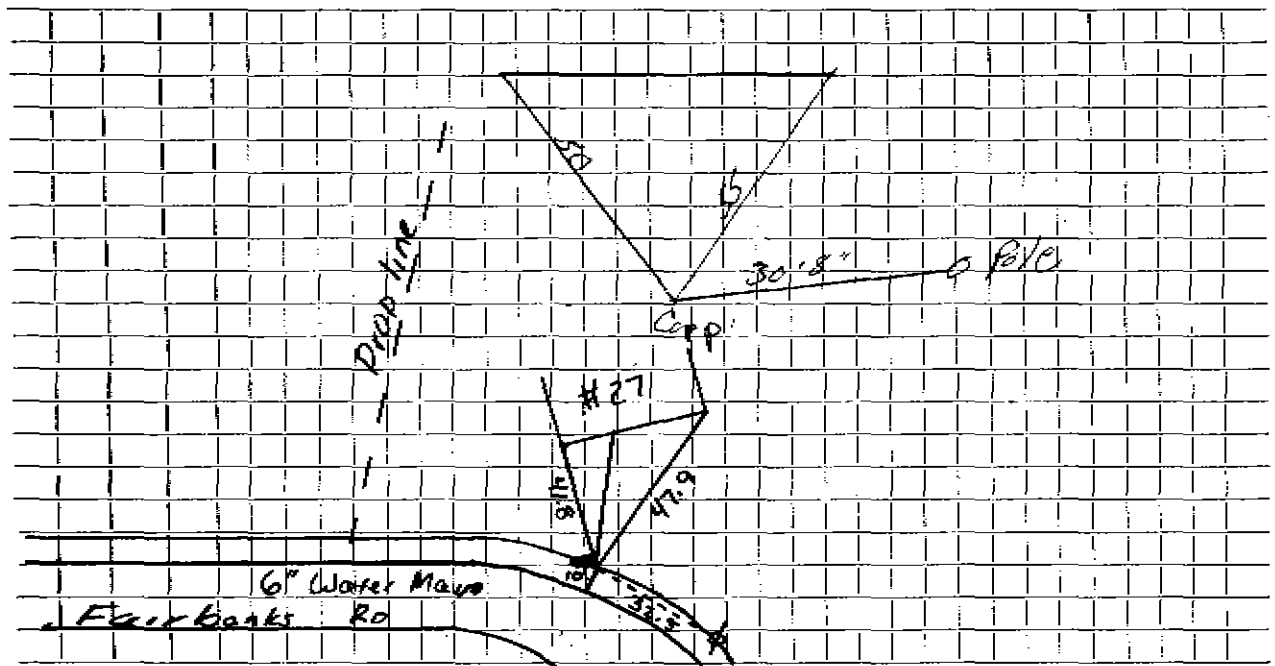

Connection made in _____ Street. Work completed

Remarks:
.....
.....