

WATER SERVICE RECORD

Name Minute Man Mason

Service No. 42

Address # 29 FAIRBANKS RD.

Location LOT # 345

~~REPAIR WORK~~ - New Service

Comm 8-4-58


Date	Material	Amount	Total	Date	Amount	
4-30-58	Labor	3.71		4-8-58	Deposit	35.00
	10% overhead	.37	4.08	8-26-58	Paid	2.24
65'	3/4" Copper tubing @.37		24.05			36.24
1	3/4" Cx 3/8 I.W.H. Stop & Waste		5.84		NON CHARGE	
1	3/4" C 3 part Union		2.27	1	1/8 Straight tail piece	.50
			36.24	1	1/8 Offset tail piece	.50
						1.00

Paid 8-26-58 1.24

DATE _____

TOWN OF LEXINGTON — BOARD OF PUBLIC WORKS
WATER DIVISION

Sketch of Service Here

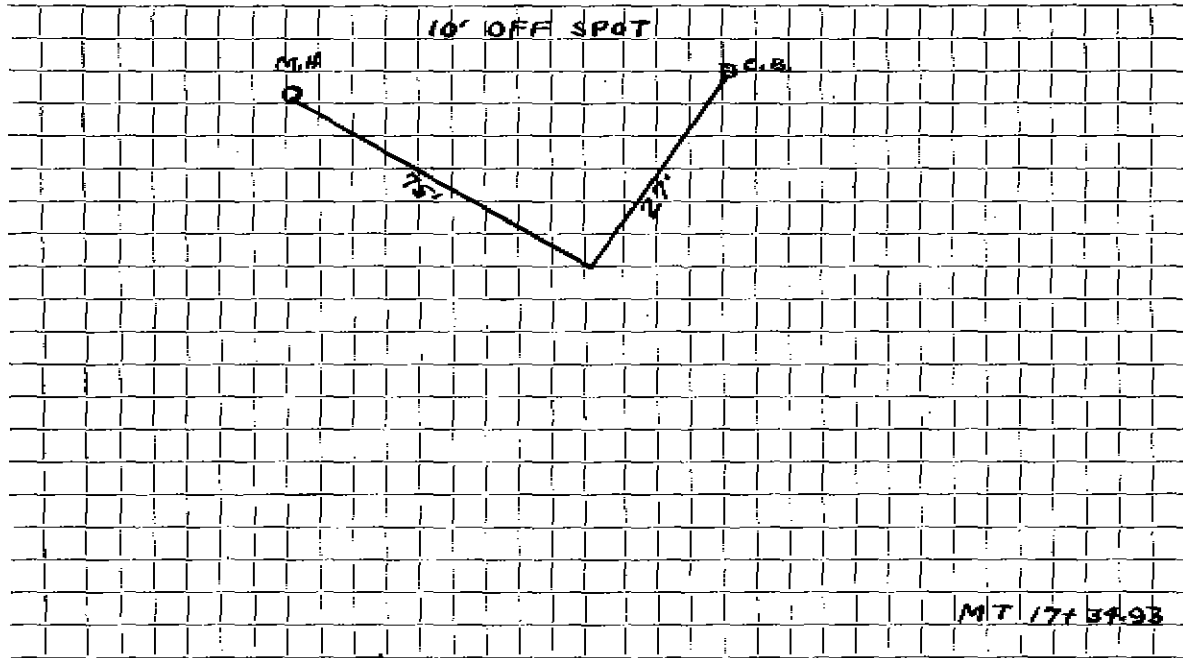

Connection made in Street. Work completed

Remarks:

.....

.....