


DATE _____

TOWN OF LEXINGTON — BOARD OF PUBLIC WORKS
WATER DIVISION

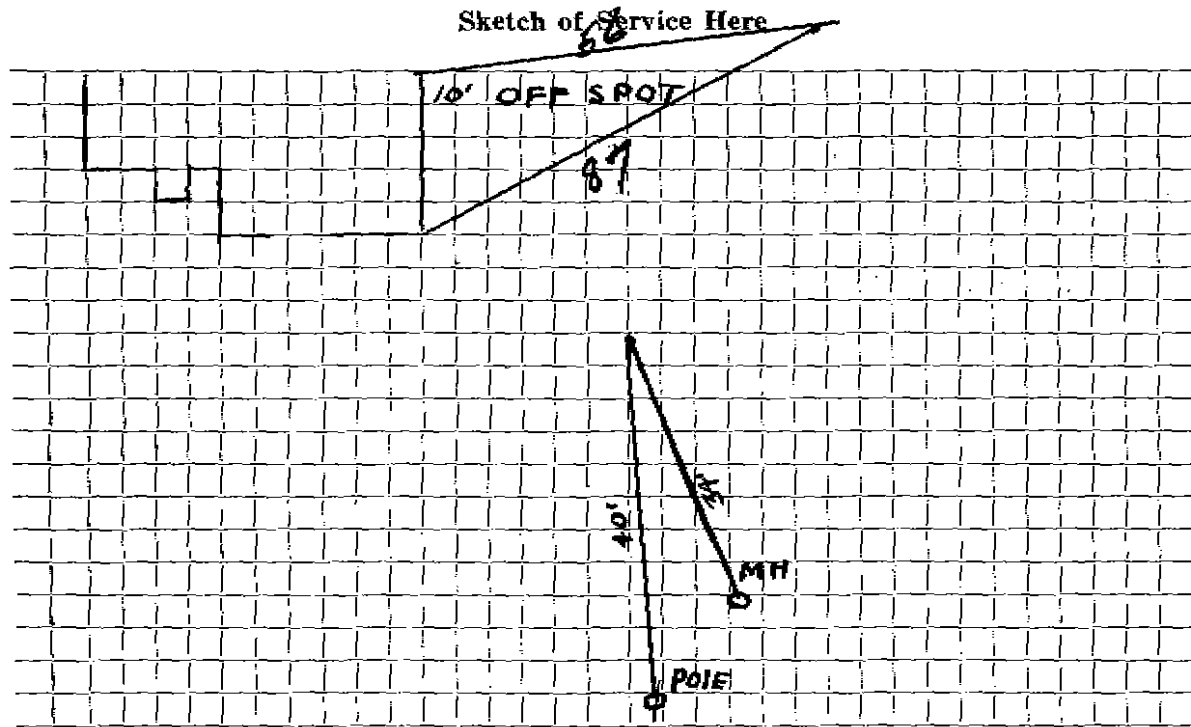

Connection made in _____ Street. Work completed _____

Remarks: *Sewer Service to Easement*

.....
.....