

WATER SERVICE RECORD

#5559

Name Edward L. Beaulieu

Service No. 381 (1956)

Address # 35 FAIRBANKS RD.

Location LOT 342

~~RANGE~~ ~~RANGE~~ - New Service

Comm. 3/18/57


Date	Material	Amount	Total	Date	Amount	
12-12-56	Labor	1.90		12-11-56	Deposit	\$ 50.00
	10% O.H.	.20	2.10	3-18-57	Refund	20.21
	50' 3/4" Copper Tubing @.4396		21.98			\$ 29.79
	1 3/4" C x 1/2 I.W.H. Stop & Waste	4.96			NON CHARGE	
	1 hr. Trucking @.75		.75	12-12-56		
			29.79		1 1/2 Straight tailpiece	.50
					1 1/2 Offset tailpiece	.50
						1.00

DATE \_\_\_\_\_

TOWN OF LEXINGTON — BOARD OF PUBLIC WORKS

WATER DIVISION

Sketch of Service Here

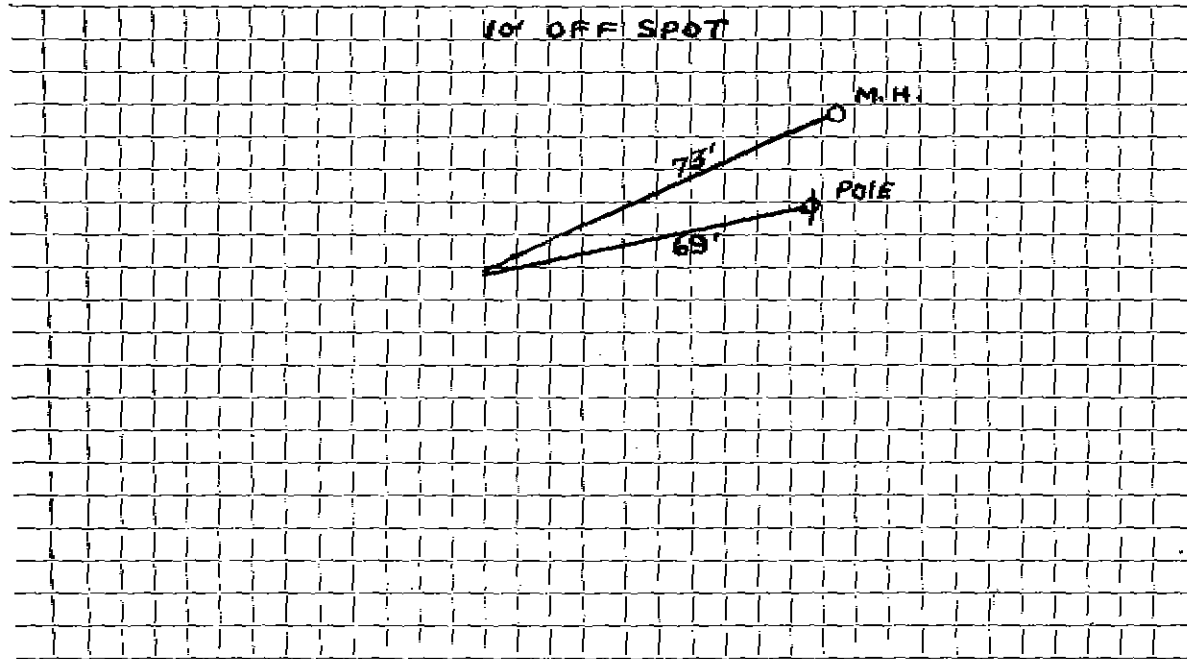

Connection made in \_\_\_\_\_ Street. Work completed \_\_\_\_\_

Remarks: \_\_\_\_\_

\_\_\_\_\_

\_\_\_\_\_