

WATER SERVICE RECORD

1141

Name Henry J. Moulton

Service No. 256

Address 4 Fairbanks Road

Location

~~REPAIR WORK~~ - New Service

Com. 11-8-54


Date	Material	Amount	Total	Date	Amount
10/15/54	Labor	1 85		10-17-54	Deposited 25 00
	10% overhead	19	2 04	11-8-54	Refunded 71
	50' - 3/4" copper tubing @ .35		17 50		<u>NON CHARGE</u> 24 29
	1 - 3/4" C x 1/2 I.W.H. stop & waste		4 00		SERVICE WAS IN TO CURB:
	1 hr. trucking		75	1 - 1/2 straight tail piece	50
			24 29	1 - 1/2 offset tail piece	50
	TRENCH DUG BY OWNER:				<u>1 00</u>
					NON CHARGE
				7/2/54	25' 3/4" Copper Tubing
					1 3/4" C Corp Calk
					1 3/4" C x 3/4" C. Curb Calk
					1 Box & Rod

DATE _____

TOWN OF LEXINGTON — BOARD OF PUBLIC WORKS

WATER DIVISION

Sketch of Service Here

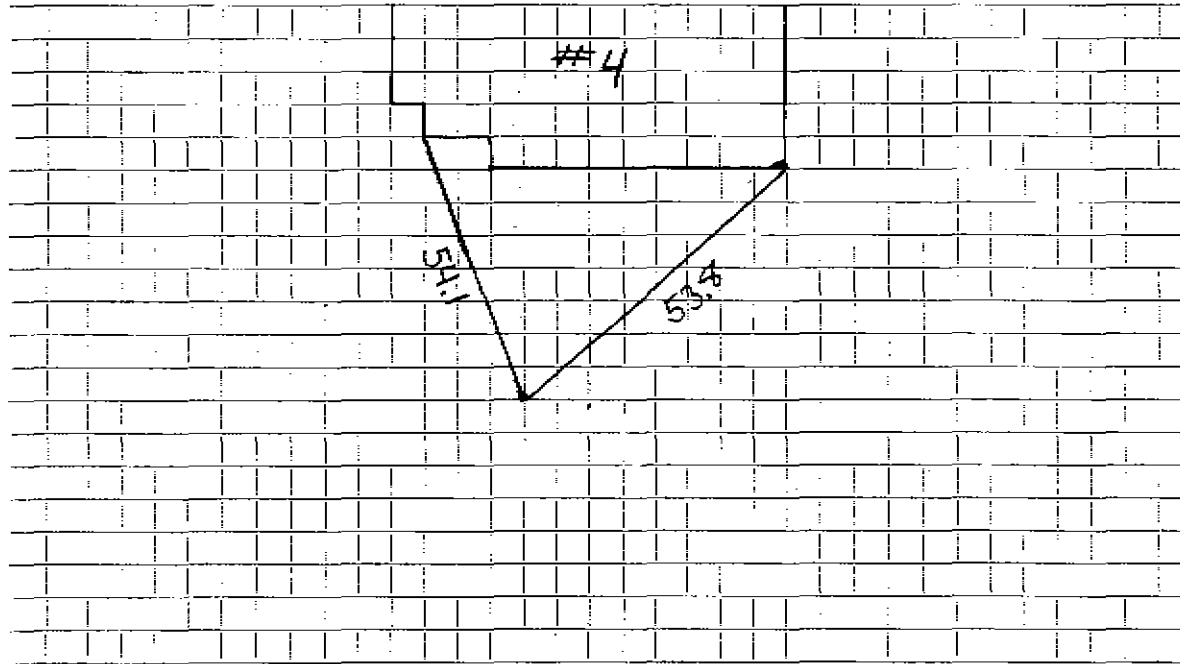

Connection made in Street. Work completed

Remarks:

.....

.....