

WATER SERVICE RECORD

Name Joseph B. Carabbie

Service No. 183

Address 40 Fairbanks Road

32/0

Location

Repair—Renewal—New Service


Comm. 11-19-56

Date	Material	Amount	Total	Date	Amount
7/5/56	Labor	11 21		7-5-56 Deposit	50 00
	10% overhead	1 12	12 33	11-19-56 Refund	8 19
	49' 3/4" copper tubing @.4850		23 77	<u>NON CHARGES</u>	41 81
	1 3/4"C x 1/2" I.W.H. stop&waste		4 96	Labor	6 64
	1 hr. trucking @ .75		75	29' 3/4" copper tubing @.4850	14 07
			41 81	1 3/4"C Corp Cock	4 64
				1 3/4"C Curb Cock	5 94
				1 Box & Rod	4 62
				1 1/2 Straight Tail Piece	50
				1 1/2 Offset Tail Piece	50
				1 hr. trucking @ .75	75
					<u>37 66</u>

DATE _____

TOWN OF LEXINGTON — BOARD OF PUBLIC WORKS
WATER DIVISION

Sketch of Service Here

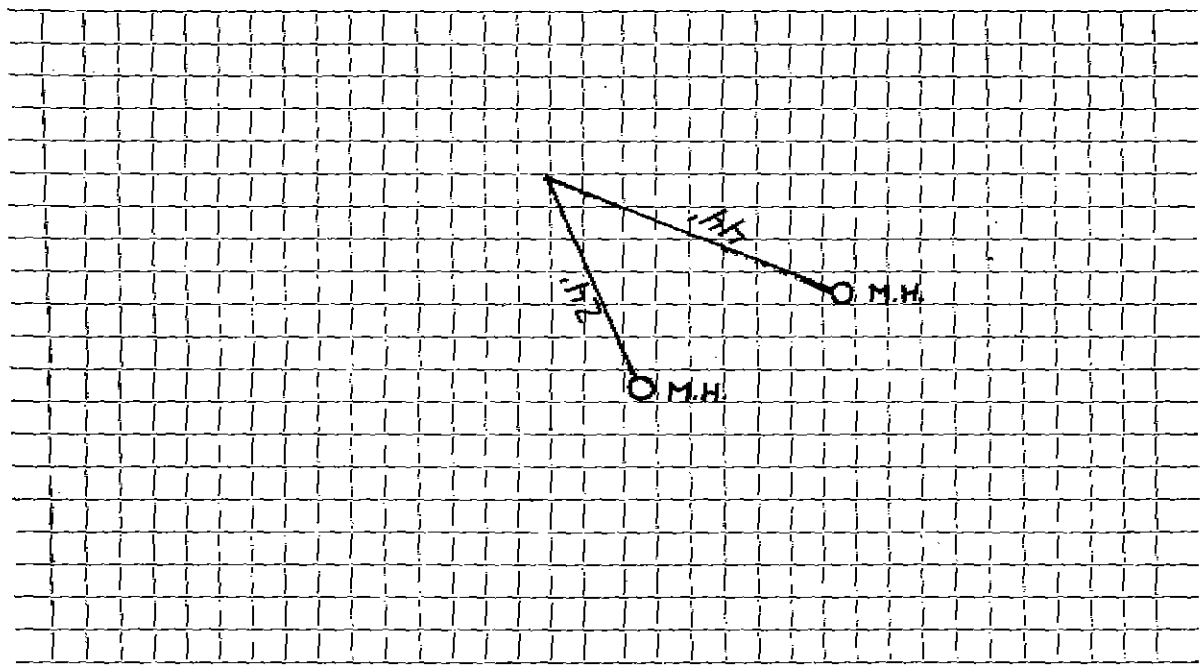

Connection made in Street. Work completed

Remarks:
.....
.....