

WATER SERVICE RECORD

Name James F. Kelly

Service No. 118

Address # 41 FAIRBANKS RD.

Location LOT # 333

~~Repaired~~ New Service

Comm 11-13-61


Date	Material	Amount	Total	Date	Amount
9-1-61	Labor	4.36		8-17-61	50.00
	10% O.H.	.44	4.80	11-13-61	16.77
53'	3/4" Copper tubing @.42		22.26		33.23
1	3/4" C x 1/2 I.W.H. Stop & Waste		6.17		
			33.23		
					NON CHARGE
				1	1/2 Straight tailpiece .50
				1	1/2 Offset tailpiece .50
					1.00

DATE \_\_\_\_\_

# TOWN OF LEXINGTON — BOARD OF PUBLIC WORKS

## WATER DIVISION

Sketch of Service Here

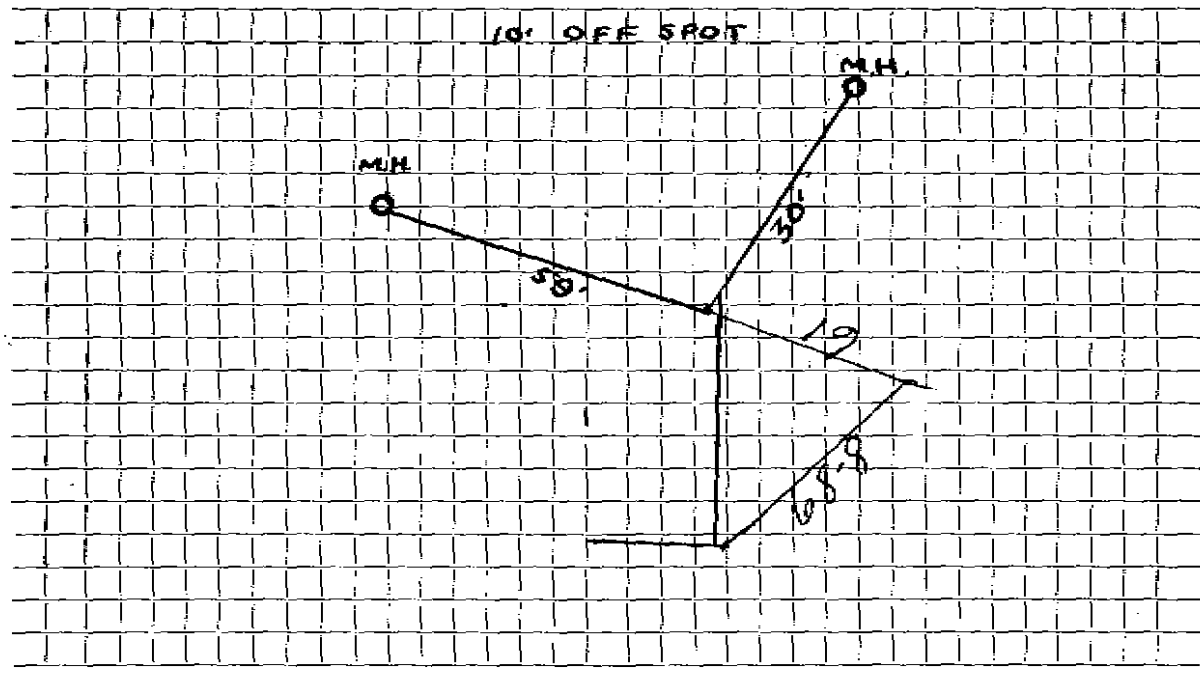

Connection made in ..... Street. Work completed .....  
.....

Remarks: .....  
.....  
.....